


Section 4 Township 21 Range 6W

Well No. 3 Johnson

Company Sterling Drlg.

Welch Pool
NORTH

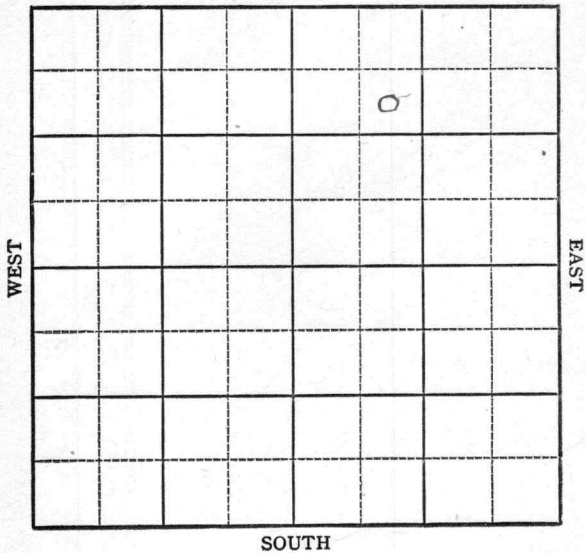

Sec. 4 Twp. 21 R. 6W

Well No. 3 Johnson Farm

Sterling Drlg. Company
Welch Pool


990 Ft. from N. Line

 Ft. from S. Line

 Ft. from E. Line

990 Ft. from W. Line

SE NW NE

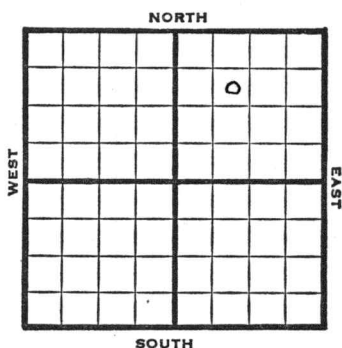

1948

Elev. 1612' REPORT

8/25 Location

9/1 "

9/8 8" @ 105'
Drlg. 3875'

9/14 Mississippi 3423'
TD 3427'
5" @ 3423'
700' oil

9/22 Miss 3423'
5" @ 3423'
TD 3448'
20 qts 3434-44
Gr. 38°
Pump 50 Pot.

COMPLETED

Rice County Kansas State
 Map No. 48 Sec. 4 Twp. 21 R. 6W
 Well No. 3 Johnson

Sterling Drlg. Company

COMPLETE

Contractor

SE NW NE

E 11/6/12
 SECTION PLAT

990 Ft. from N. Line

 Ft. from S. Line

 Ft. from E. Line

990 Ft. from W. Line

Welch Pool

Remarks:

Min 3423
5" 3423
7.17 3445
209 to 3434-44
Pump 50 Pk
38° 42.

Date
 SEP 22 1948

Scout S. J. LEWIS

Rice County Kansas StateMap No. _____ Sec. 4 Twp. 21 R. 6WWell No. 3 JohnsonSterling Drlg. Company**FIRST REPORT**

SE NW NE Contractor

SECTION PLAT990 Ft. from N. Line

_____ Ft. from S. Line

_____ Ft. from E. Line

990 Ft. from W. Line

Welch Pool

Remarks:

Location

Date

AUG 25 1948

Scout

S. J. LEWIS