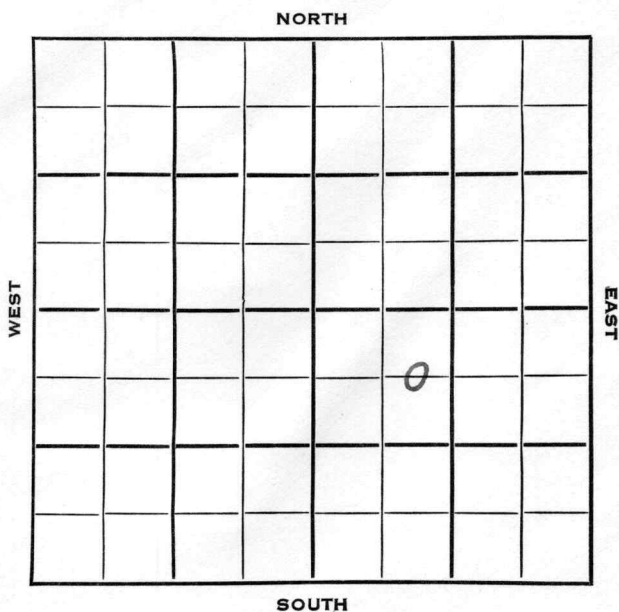


Section 13 Township 25 Range 1 EWell No. # 2 MayallCompany Bennett & Gould

Sedgwick

KANSAS

SEC.	TWP.	R.
13	25	1 E ✓

WELL NO.

2 Mayall

FARM

COMPANY

Bennett & Gould

CONTRACTOR

Salina Drlg.

Kuske Pool

660

Ft. from N. Line


Ft. from S. Line

Ft. from E. Line

990

Ft. from W. Line

C E L NW SE

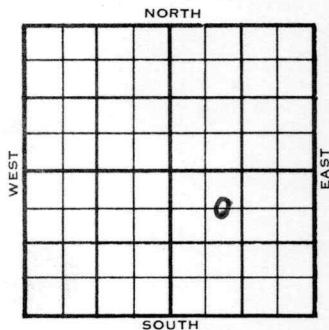

1953

ELEVATION

1432'

REPORT

10/14

Spud 10-11-53

8" @ 121 WOC

10/28


Spud 10-11-53 Oil well TD 3009'

8" @ 121 Burgess 3004' TD 3009

5" @ 3007 CO to 3009 1½ BOPH

10 hr. Comp. 35 BOPD

COMPLETED

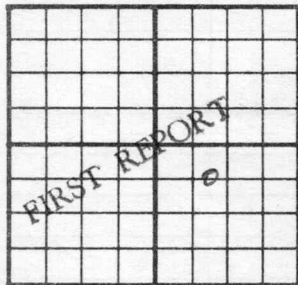
County Sedgwick State KansasSec. 13 (Blk.) 25 (Sur.) 1E (Twp.) 1E Map No.Operator Bennett & GouldWell No. 2 Farm MayallElev. Location C E L NW SE660 Ft. From N Line SE990 Ft. From W Line Quarter1st. Report OCT 14 1953

Completion

Remarks

Salina Drlg. - Contr.Spudding Date 10-11-53Drlg. Data Kiske Pool8" @ 121 WOC

County Sedgwick State Kansas
 Sec. 13 (Blk.) 25 (Sur.) 1E Map No. _____
 Operator Bennett & Gould
 Well No. 2 Farm Mayall
 Elev. 1432 Location C E L NW SE

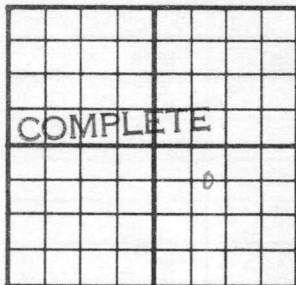

660 Ft. From N Line SE
990 Ft. From W Line Quarter

1st. Report

Completion OCT 28 1953

Remarks Kuske Pool

Salina Drlg. - Contr.

Spudding Date 10-11-53

Drlg. Data Oil well TD 3009
8" @ 121 Burgess 3004 TD 3009
5" @ 3007 CO to 3009 $1\frac{1}{2}$ boph 10 hr.
Comp. 35 bopd

J. G. McGEHEE