


Map No. \_\_\_\_\_ Sec. 9 Twp. 25 R. 9

Well No. 1 Dunlap Farm \_\_\_\_\_  
Rogers & Butler Company \_\_\_\_\_

NORTH

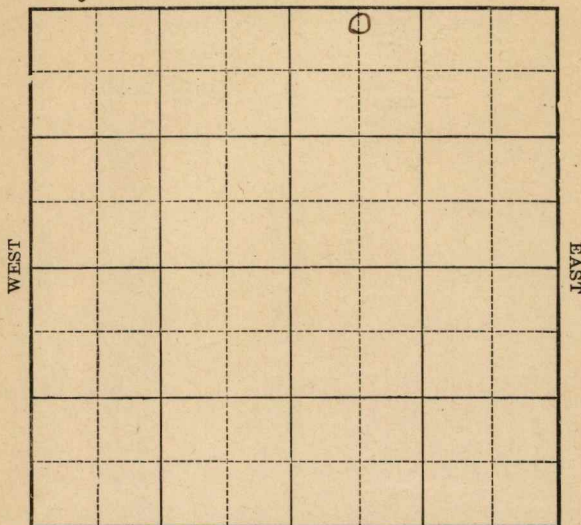

Location \_\_\_\_\_

Drilling Remarks:

\_\_\_\_\_  
 \_\_\_\_\_  
RECORD

Cased \_\_\_\_\_ in. \_\_\_\_\_ ft.  
 Sand \_\_\_\_\_  
 Gas \_\_\_\_\_  
 Oil \_\_\_\_\_  
 Total Depth \_\_\_\_\_

Rig Up \_\_\_\_\_

Drilling Remarks:

\_\_\_\_\_  
 \_\_\_\_\_  
PRODUCTION

1st 24 hrs. Nat. \_\_\_\_\_  
 1st 24 hrs. after shot \_\_\_\_\_  
 Gas \_\_\_\_\_ cu. ft.  
 Dry Hole \_\_\_\_\_  
 Abandoned \_\_\_\_\_

Map No. \_\_\_\_\_ Sec. 9 Twp. 25 R. 9


Well No. 1 Dunlap Farm \_\_\_\_\_  
Rogers & Bittler Company \_\_\_\_\_

200 Ft. from N. Line

\_\_\_\_\_ Ft. from S. Line

\_\_\_\_\_ Ft. from E. Line

660 Ft. from W. Line

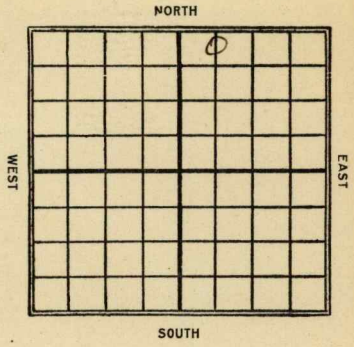

Date	REPORT
1923	
2/6	Rig
3/22	D. & A. 2230'

Map No. <sup>15</sup> **KANSAS** Sec. 9 Twp. 25 R. 9

Well No. 1 Lounslap

Rogers & Butler Company  
 \_\_\_\_\_ Contractor

**FIRST REPORT**

200 Ft. from N. Line  
 \_\_\_\_\_ Ft. from S. Line  
 \_\_\_\_\_ Ft. from E. Line  
660 Ft. from W. Line

**SECTION PLAT**

		0	

Location \_\_\_\_\_  
 Rig up    
 Drilling and Remarks:

**RECORD**

Cased \_\_\_\_\_ in., \_\_\_\_\_ ft.  
 Sand \_\_\_\_\_  
 Gas \_\_\_\_\_  
 Oil \_\_\_\_\_  
 Total Depth \_\_\_\_\_

**PRODUCTION**

1st 24 hrs. Nat. \_\_\_\_\_  
 1st 24 hrs. after shot \_\_\_\_\_  
 Gas \_\_\_\_\_ Cu. Ft.  
 Dry Hole \_\_\_\_\_  
 Abandoned \_\_\_\_\_

Date **FEB 6 1923**

**M. A. BENEAR**

Map No. **KANSAS** 15 Sec. 9 Twp. 25 R. 9

Well No. 1 Humlap

Rager & Butler Company

Contractor

# ABANDONED SECTION PLAT

200 Ft. from N. Line

\_\_\_\_\_ Ft. from S. Line

\_\_\_\_\_ Ft. from E. Line

660 Ft. from W. Line

		0	

Location \_\_\_\_\_

Rig up \_\_\_\_\_

Drilling and Remarks:

D & A

2230'

## RECORD

Cased \_\_\_\_\_ in., \_\_\_\_\_ ft.

Sand \_\_\_\_\_

Gas \_\_\_\_\_

Oil \_\_\_\_\_

Total Depth \_\_\_\_\_

## PRODUCTION

1st 24 hrs. Nat. \_\_\_\_\_

1st 24 hrs. after shot \_\_\_\_\_

Gas \_\_\_\_\_ Cu. Ft.

Dry Hole \_\_\_\_\_

Abandoned \_\_\_\_\_

Date

MAR 22 1923

M. A. BENEAR

192

Scout