


Greenwood

KANSAS

Section 31 Township 24 Range 13-E
Well No. #3 Dinius
Company Charles Christy

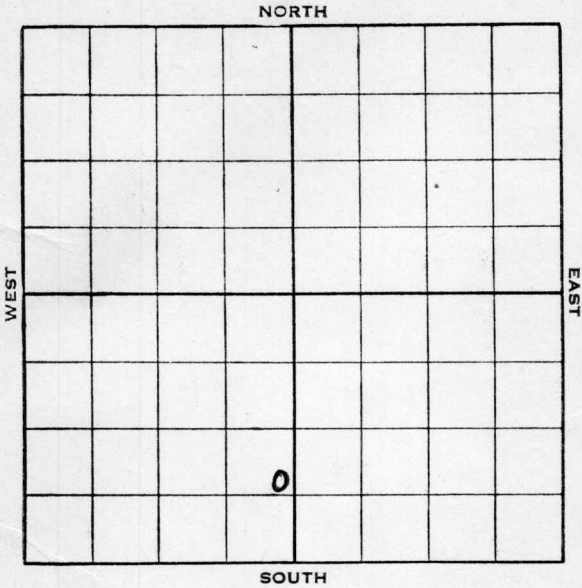

Greenwood KANSAS

Map No. 17 Sec. 31 Twp. 24 R. 13EWell No. 3 DiniusCharles Christy

Company

Contractor

FIRST REPORT

Approx.

C E L SE SW

 Ft. from N. Line700 Ft. from S. Line100 Ft. from E. Line Ft. from W. Line

SECTION PLAT

	0		

Location Rig up

Drilling and Remarks:

10" 245
D/g 650

RECORD

Cased in., ft.Sand Gas Oil Total Depth

PRODUCTION

1st 24 hrs. Nat. 1st 24 hrs. after shot Gas Cu. Ft.Dry Hole Abandoned

Date

JUL 6 - 1938 19H. D. Hatfield Scout

Greenwood KANSAS

Map No. 17 Sec. 31 Twp. 24 R. 13EWell No. 3 DiniusCharles Christy

Company

Contractor

ABANDONED

Approx.

C E L S E S W

 Ft. from N. Line700 Ft. from S. Line100 Ft. from E. Line Ft. from W. Line

SECTION PLAT

	0		

Location Rig up

Drilling and Remarks:

RECORD

Cased in., ft.Sand MISS 1663Gas Oil Total Depth 1691

PRODUCTION

1st 24 hrs. Nat. 1st 24 hrs. after shot Gas Cu. Ft.Dry Hole Abandoned

Date

JUL 27 1938

19

H. D. Hatfield

Scout