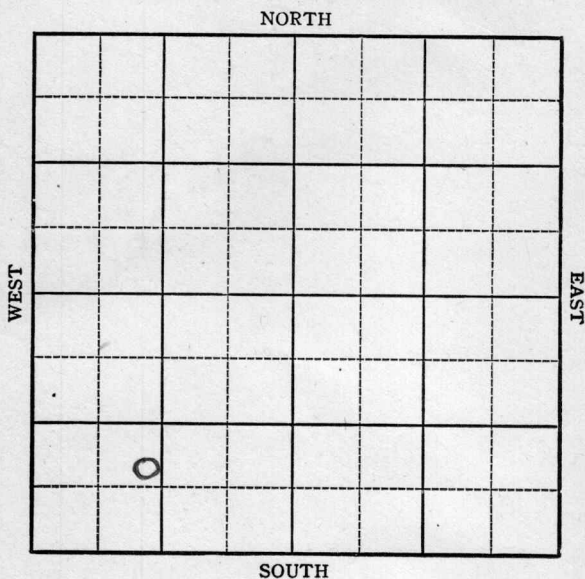


KANSAS

Section 31 Township 24 Range 13EWell No. #3 DiniusCompany Becker & Stewart etal.

Greenwood

Sec. 31 Twp. 24 R. 13E

Well No. #3 Dinius Farm

Becker & Stewart etal. Company


Miscellaneous

           Ft. from N. Line

800 Ft. from S. Line

           Ft. from E. Line

1000 Ft. from W. Line

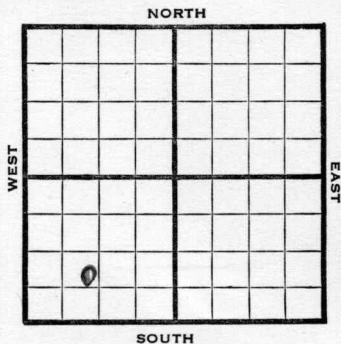

| 1944 | REPORT   |
|------|---|
| 3/29 | <div data-bbox="207 917 476 1176"><p>10" @ 486<br/>8" @ 1200<br/>TD 1740<br/>Miss. 1690<br/>H F W 1730<br/>D &amp; A</p></div> <div data-bbox="279 1246 642 1505"><p>FIRST REPORT<br/><i>and</i><br/>ABANDONED</p></div> |

KANSAS  
Map No. 17 Sec. 31 Twp. 24 R. 13EWell No. 3 DiniusBecker & Stewart et al. Company


FIRST REPORT

Contractor

NE SW SW

ABANDONED

## SECTION PLAT

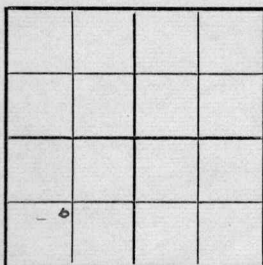

Ft. from N. Line

800 Ft. from S. Line

Ft. from E. Line

1000 Ft. from W. Line

## Miscellaneous

Location \_\_\_\_\_

Rig up \_\_\_\_\_

Drilling and Remarks:

10" - 486

8" - 1200

Miss. 1690

H F W 1730

D &amp; A

## RECORD

Cased \_\_\_\_\_ in., \_\_\_\_\_ ft.

Sand \_\_\_\_\_

Gas \_\_\_\_\_

Oil \_\_\_\_\_

Total Depth 1740

## PRODUCTION

1st 24 hrs. Nat. 0.00

1st 24 hrs. after shot \_\_\_\_\_

Gas \_\_\_\_\_ Cu. Ft.

Dry Hole \_\_\_\_\_

Abandoned \_\_\_\_\_

Date

MAR 29 1944 19

S. J. LEWIS Scout