


Section 4 Township 21 Range 6-W

Well No. #1, Sullivan

Company Branine and Holl

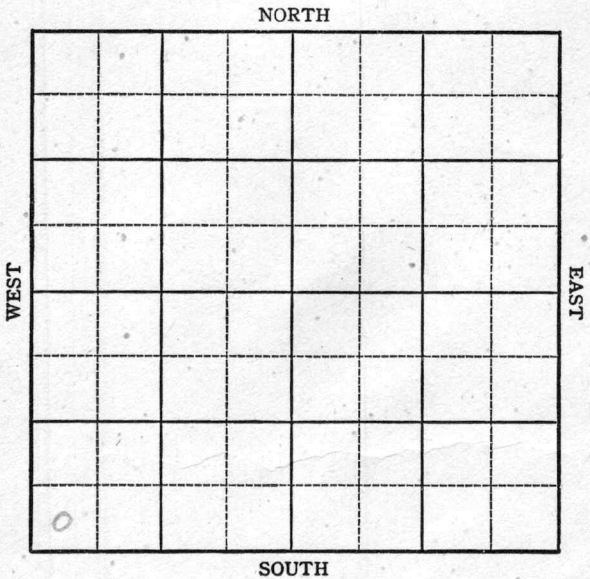

KANSAS

Rice County

Sec. 4 Twp. 21 R. 6W

Well No. 1 Sullivan Farm

Branine & Holl Company

Wildcat


Ft. from N. Line

330 Ft. from S. Line

Ft. from E. Line

330 Ft. from W. Line

SW/C

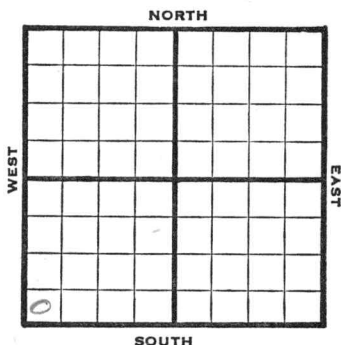

1947

REPORT

Elev. 1654

1/2 Surface Hole

1/8 8" @ 235'
Drlg 2250'

1/15 Miss 3449
TD 51'
Run 5"

1/21 5" @ 3449
TD 3466
2700' oil 12 hrs

1/29 T.D. 3475'
Estimate 400 oil

2/5 " " "

2/12 " " "

2/19 " " "

2/26 Miss 3449
5" @ 3449
Pump 200 Pot
TD 3466'

COMPLETED

Kansas KANSAS

Map No. 48 Sec. 4 Twp. 21 R. 6WWell No. 1 SullivanBranine & Holl


Company

FIRST REPORT

Contractor

SW/C

SECTION PLAT

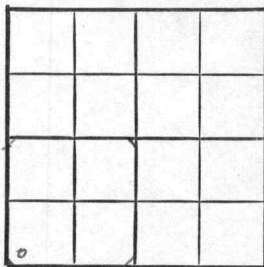 Ft. from N. Line330 Ft. from S. Line Ft. from E. Line330 Ft. from W. LineRice CountyLocation Rig up

Drilling and Remarks:

surface hole

RECORD

Cased in., ft.Sand Gas Oil Total Depth

PRODUCTION

1st 24 hrs. Nat. 1st 24 hrs. after shot Gas Cu. Ft.Dry Hole Abandoned

Date

JAN 2 1947 19S. J. LEWIS

Scout

Map No. 48 Sec. 4 Twp. 21 R. 6W

Well No. 1 Sullivan

Branine & Holl Company

COMPLETE

Contractor

SW/C

E1/1634
SECTION PLAT

 Ft. from N. Line

330 Ft. from S. Line

 Ft. from E. Line

330 Ft. from W. Line

Rice County

Location

Rig up

Drilling and Remarks:

Miss 3449
5" @ 3449
Pump 200 P.X

SS - G

RECORD

Cased in., ft.

Sand

Gas

Oil

Total Depth 3466

PRODUCTION

1st 24 hrs. Nat.

1st 24 hrs. after shot

Gas Cu. Ft.

Dry Hole

Abandoned

Date

FEB 26 1947

19

S. J. LEWIS

Scout