
Rice

KANSAS

SECTION 4 TOWNSHIP 21 RANGE 6W

WELL NO. #8 Johnson

COMPANY Sterling Drlg.

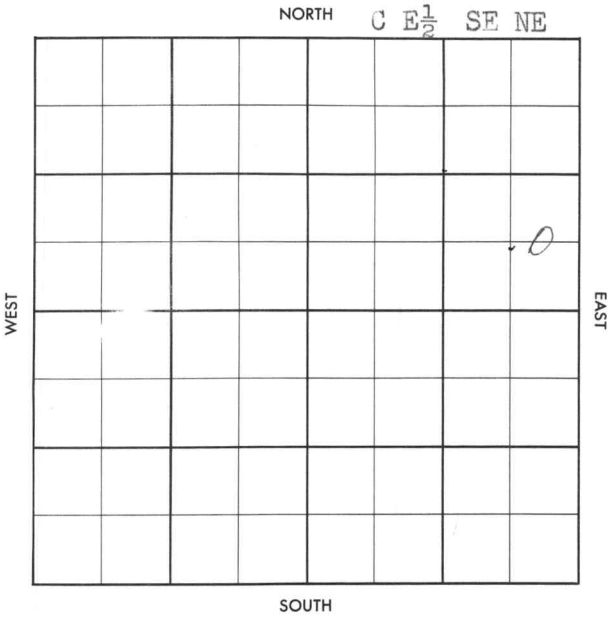

FORM 504-3 SUNRAY

FORM 513 SUNRAY

County Rice Elev.

Sec. 4 Twp. 21 Rge. 6W

Company Sterling Drlg.

Farm Name Johnson No. 8

TOPS	DEPTH	LOG	DATUM
Anh.			
Tp.			
H.			
Tr.			
Dg.			
B.L.			
L.			
K.C.			
B.K.C.			
Ce.			
C.			
M.			
M.			
K.			
Mz.			
Mo.			
V.			
S.			
S.			
A			
R.			
P€.			
G.			
T.D.			

Loc. in Sec. C E½ SE NE

Geol.

Contr. Co. tools

Pool Welch-Bornho

FIRST REPORT

MAR 20 '57

Date Comm. 3-15-57

8" @ 160/125 drlg. 780

12

Co. Lse. No. Sec.

FORM 513 SUNRAY

County Rice Elev. 1600

Sec. 4 Twp. 21 Rge. 6W

Company Sterling Drlg.

Farm Name Johnson No. 8

TOPS	DEPTH	LOG	DATUM
Anh.			
Tp.			
H.			
Tr.			
Dg.			
B.L.			
L.	2820		
K.C.			
B.K.C.			
Ce.			
C.	3351		
M. chat	3415		
M.			
K.			
Mz.			
Mo.			
V.			
S.			
S.			
A			
R.			
P€.			
G.			
T.D.	3491		

Loc. in Sec. C E½ SE NE

Geol.

Contr. Co. tools

Pool Welch-Bor

MAY	1	'57
COMPLE		

Date Comm. 3-15-57

8" @ 160/125 drlg. 780 MAR 27 '57 APR 3

5½ 3491 /125 APR 10 '57 APR 17 '57 CO

15/3418-24 /14 S.L. 12 hrs FO

190 oil in 12 hrs Frac &

13 BFph 40% wtr TP Pot

APR 24 '57 MAY 1 '57 P. 20 Bopd + 40

wtr