

Greenwood


FORM 51

KANSAS

Section 3 Township 25 Range 9E

Well No. #14 Diebert

Company Glenwood Oil

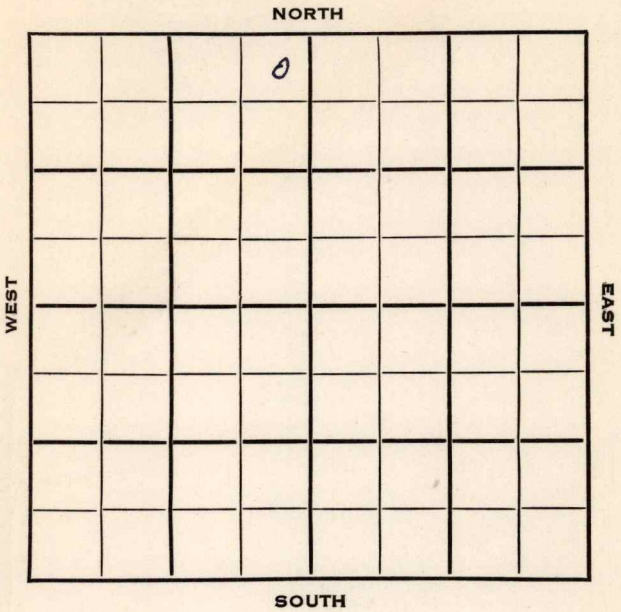

Greenwood KANSAS


SEC.	TWP.	R.
3	25	9E ✓

WELL NO. 14 Diebert FARM

COMPANY Glenwood Oil

CONTRACTOR Mora

330 Ft. from N. Line  
 \_\_\_\_\_ Ft. from S. Line  
 330 Ft. from E. Line  
 \_\_\_\_\_ Ft. from W. Line

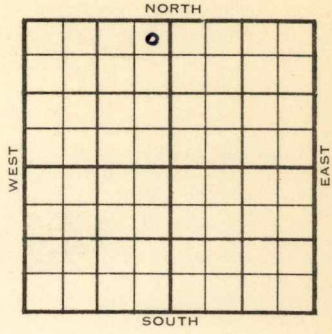

NE NE NW

	ELEVATION	REPORT
1954	---	

3/24 Spud 3-17-54  
 7" @ 65'  
 Doug. 1160'  
 Drlg. 1478'

4/7 Spud 3-17-54 Oil well TD 2225  
 7" @ 65 Doug. 1160 Bart. 2206'  
 TD 2225 4" @ 2225 CO to 2225  
 45/2208-23 Comp. 25 BOPD

**COMPLETED**



County **Greenwood** State **Kansas**

Sec. **3** (Blk.) **25** (Sur. Rge.) **9E** Map No.

Operator **Glenwood Oil**

Well No. **14** Farm **Diebert**

Elev. Location **NE NE NW**


**330** Ft. From **N** Line **NW**

**330** Ft. From **E** Line **Quarter**

1st. Report **MAR 24 1954**

Completion

Remarks

**Mora - Contr.**

Spudding Date **3-17-54**

Drlg. Data

**7" @ 65 Doug. 1160 drlg. 1478**