


Section 31 Township 24 Range 13E

Well No. 203 Pusey

Company Delhi - Taylor Oil Corp.

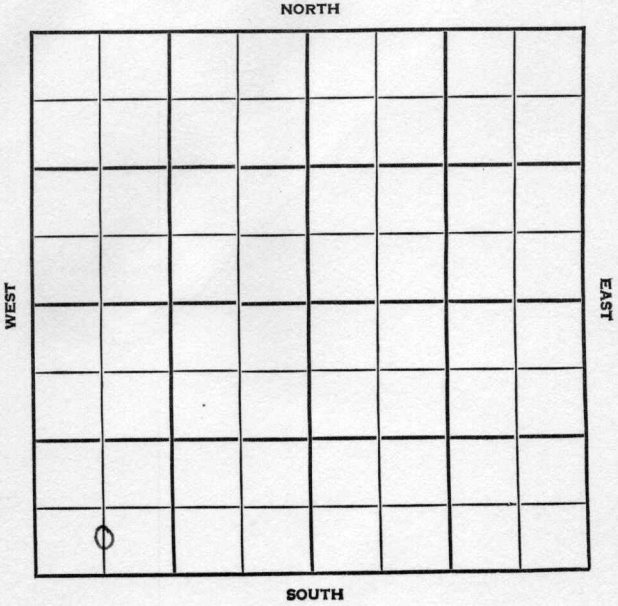

Greenwood

KANSAS

SEC.	TWP.	R.
31	24	13E

WELL NO.

#203 Pusey

FARM

COMPANY

Delhi-Taylor Oil Corp.

CONTRACTOR

Barker

N. Quincy

Ft. from N. Line


Ft. from S. Line

Ft. from E. Line

Ft. from W. Line

C S $\frac{1}{2}$ SW SW

48' SL, 660' WL

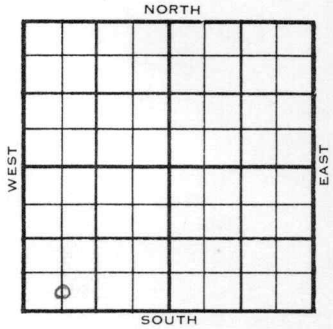

1955

ELEVATION

REPORT

7/20

Comm 6-5-55

TD 1563 5" @ 1561 CO to 1563

frac Comp. 5 bopd

S. Bart. 1542

FIRST REPORT
+
COMPLETED

County Greenwood Elev. _____
 Sec. 31 Twp. 24 Rge. 13E
 Company Delhi - Taylor Oil Corp.
 Farm Name Pusey No. 203

TOPS	DEPTH	LOG	DATUM
Anh.			
T.P.			
H.			
Tr.			
Dg.			
BL.			
L.			
K.C.			
B.K.C.			
Ce.			
C.			
M.			
M.			
K.			
Mz.			
Mq.			
V.			
S.			
S.	<u>Bart.</u>	<u>1542</u>	
A.			
R.			
Pe.			
G.			
TD.			

Loc. in Sec. _____

C S $\frac{1}{2}$ SW SW48' SL660' WL

Geol. _____

Contr. _____

Barker

Pool _____

N. QuincyJUL 20 '56

**FIRST REPORT
COMPLETE**

Date Comm. 6-5-55TD 1563 5" @ 1561 CO to 1563frac Comp. 5 bopd