


Section 3 Township 25 Range 9E

Well No. 13 No. Diebert

Company Glenwood Oil

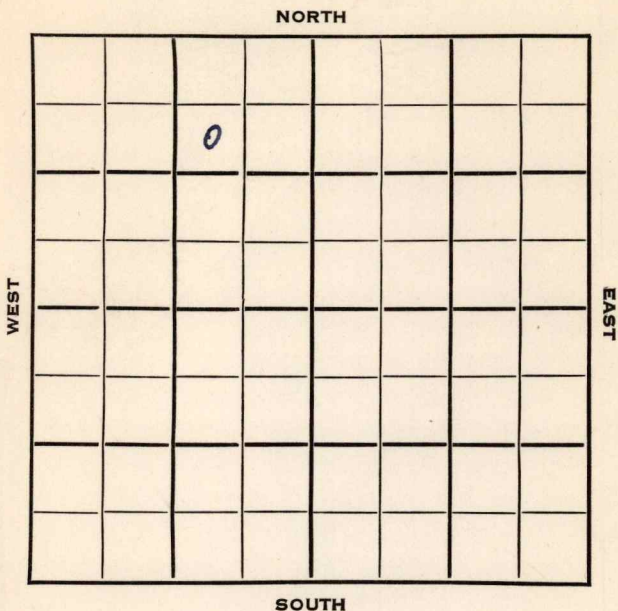


SEC. 3 TWP. 25 R. 9 E ✓

WELL NO. # 13 No. Diebert FARM

COMPANY # 13 No. Diebert FARM

CONTRACTOR Glenwood Oil

Mora Drlg.  
 Polhamus Pool  
 990 Ft. from N. Line  
 Ft. from S. Line  
 990 Ft. from E. Line  
 Ft. from W. Line

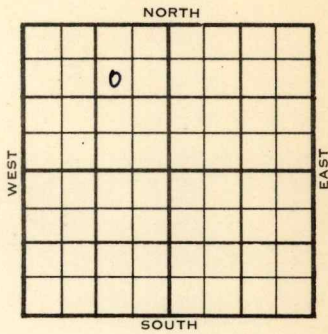

SW NE NW

ELEVATION	REPORT
1954	
3/10	RUR
3/31	Spud 3-1-54 Oil well TD 2303 7" @ 66 TD 2303 4" @ 2301 Bart 2279 <del>XXX</del> CO to 2300 40/2280-2300 100 A Comp. 28 BOPD 50% wtr.
	<p><b>COMPLETED</b></p>



County Greenwood State Kansas  
 Sec. 3 (Blk. 25) (Sur. Rge.) 9E Map No. \_\_\_\_\_  
 Operator Glenwood Oil  
 Well No. 13 Farm N. Diebert  
 Elev. \_\_\_\_\_ Location SW NE NW



990 Ft. From N Line NW  
 990 Ft. From E Line Quarter  
 1st. Report \_\_\_\_\_  
 Completion MAR 31 1954  
 Remarks Polhamus Pool  
Mora Drig. - Contr.  
 Spudding Date 3-1-54

Drig. Data Oil well TD 2303  
7" @ 66 TD 2303 4" @ 2301 Bart. 2279  
CO to 2300 40/ 2280-2300 100 A  
Comp. 28 bopd 50% wtr.