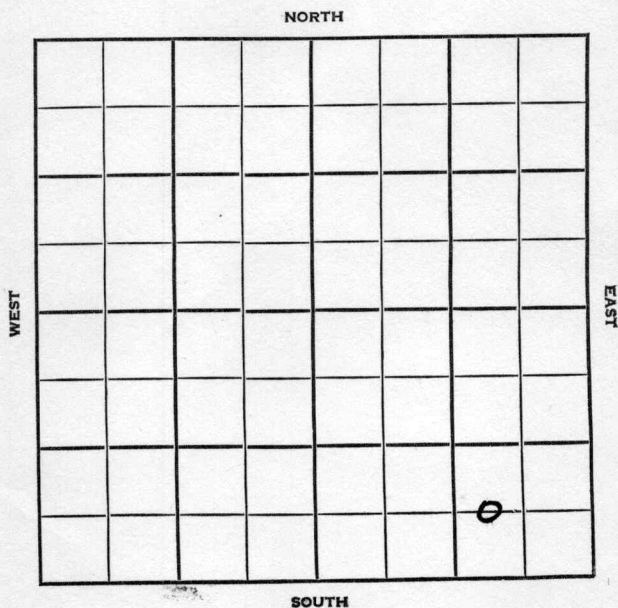


DX 78-1

Section 31 Township 24 Range 13EWell No. 1 KingCompany True Ashlock et al

Greenwood KANSAS

SEC.	TWP.	R.
31	24	13E

WELL NO.

1 King

FARM

COMPANY

True Ashlocke t al

CONTRACTOR

Co. Tools


Quincy Flood Pool

_____ Ft. from N. Line

660 _____ Ft. from S. Line

990 _____ Ft. from E. Line

_____ Ft. from W. Line

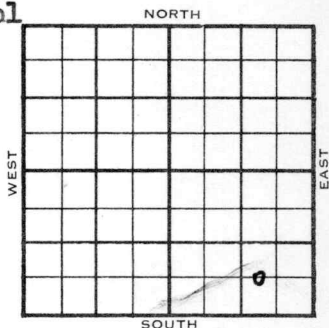

C W/2 SE SE

	ELEVATION	REPORT
1954	-	

8/4 Spud 5-15-54
12" @ 24'
Drlg. 263'

1955
1/19 Spud 5-15-54 - Oil Well
TD 1560'
12" @ 24'
7" @ 1048'
Bart. 1510'
TD 1560'
5" @ 1508'
CO to 1520'
Comp. 20 bopd

COMPLETED


County Greenwood State KansasSec. 31 (Blk. Twp.) 24 (Sur. Rge.) 13E Map No.Operator True Ashlock et al.Well No. 1 Farm KingElev. Location C W $\frac{1}{2}$ SE SE660 Ft. From S Line SE990 Ft. From E Line Quarter1st. Report AUG 4 1954

Completion

Remarks

Co. toolsSpudding Date 5-15-54Drlg. Data Quincy Flood Pool12" @ 24 drlg. 263

County Greenwood State Kansas
 Sec. 31 (Blk. 24 (Sur. 13E Map No.
 (Twp. (Rge.
 Operator True Ashlock etal.
 Well No. 1 Farm King
 Elev. Location C W $\frac{1}{2}$ SE SE

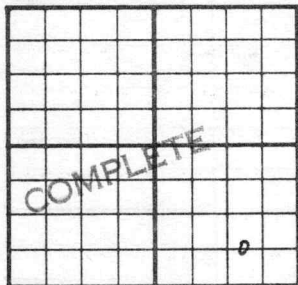

660 Ft. From S Line SE
990 Ft. From E Line Quarter
 1st. Report
 Completion JAN 1 9 1955
 Remarks Quincy Flood Pool
Co. tools
 Spudding Date 5-15-54

Drlg. Data Oil well TD 1560
12" @ 24 7" @ 1048 Bart. 1510
TD 1560 5" @ 1508 CO to 1520
Comp. 20 bopd

FABEN GIL STRAP