


Section 31 Township 24 Range 13-E

Well No. 4 Pusey

Company ~~Chas Christy~~ Mills Oil

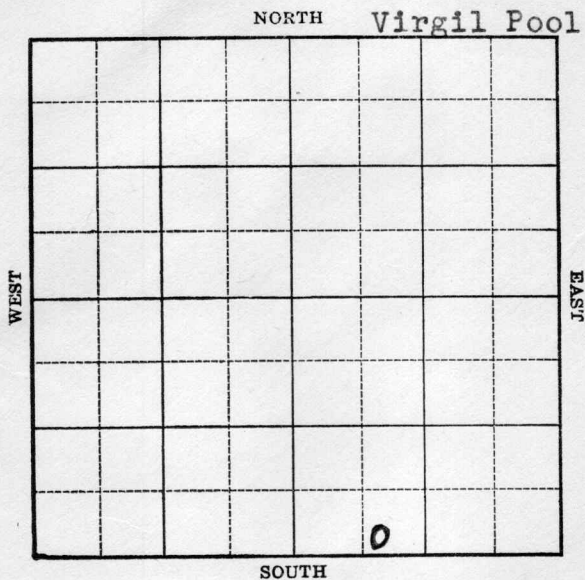


KANSAS

Greenwood

Sec. 31 Twp. 24 R. 13-EWell No. #4 Pusey Farm~~Chas. Christy Mills Oil~~ Company

(Virgil)

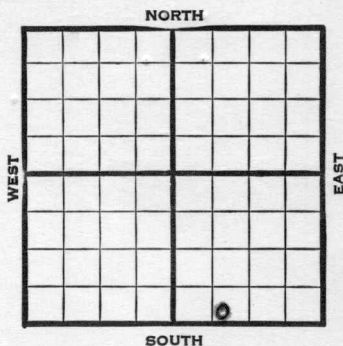 Ft. from N. Line200 Ft. from S. Line Ft. from E. Line800 Ft. from W. Line

1939	REPORT
5/17	Machine .
5/26	"
6/1	"
6/8	"
6/16	"
6/23	"
6/29	10" - 237' T.D. 390' SD.
7/6	Drig. 850'
7/13	8" - 1157' Drig. 1450'
7/20	Bart. 1536-1545' T.D. 1565'
	P. B. 1548'
7/27	Shut down.
8/3	T.D. 1565' P. B. to 1548'
8/10	Shut down.
8/17	T.D. 1549' SD.
8/24	Shot 40 qts. 1538-44' No test.
8/31	6" - 1530' S.D.
9/7	6" - 1526' Woc.
9/14	" " "
9/21	" " "
	OVER

1939

9/27

Bart. 1536'

T.D. 1565'

P. B. to 1549'

Shot 40 qts. 1533-44'

6" - 1526'

Pump 8 bbls.

COMPLETED

Greenwood KANSAS

Map No. _____ Sec. 31 Twp. 24 R. 13EWell No. 4 PuseyChas. Christy

Company

Contractor

FIRST REPORT

C W L SW SE


____ Ft. from N. Line

200 Ft. from S. Line

____ Ft. from E. Line

800 Ft. from W. Line

SECTION PLAT

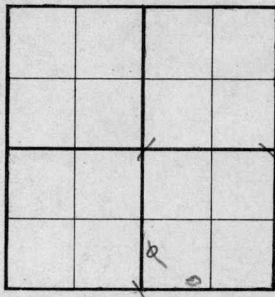

VIRGIL POOL

Location _____

Rig up _____

Drilling and Remarks:

Mach.

RECORD

Cased _____ in., _____ ft.

Sand _____

Gas _____

Oil _____

Total Depth _____

PRODUCTION

1st 24 hrs. Nat. _____

1st 24 hrs. after shot _____

Gas _____ Cu. Ft.

Dry Hole _____

Abandoned _____

Date


MAY 17 1939 19

S. J. LEWIS

Scout

Please check spot & feet
measurements and advise.

Paul.

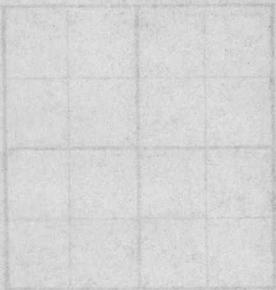

- Misc. Small Maps.....
- Cards.....
- Tracing.....
- France Map.....
- Scarborough Map.....
- Moody Map.....
- Geological Dept.
- Moody Flat Book

Map No. 17 Sec. 31 Twp. 24 R. 13EWell No. 4 PuseyChas Christy

Company

Contractor

First Report

SE SW SE

 Ft. from N. Line200 Ft. from S. Line Ft. from E. Line800 Ft. from W. Line

VIRGIL POOL

SECTION PLAT

CORRECTION

Location Rig up

Drilling and Remarks:

Mach.

RECORD

Cased in., ft.Sand Gas Oil Total Depth

PRODUCTION

1st 24 hrs. Nat. 1st 24 hrs. after shot Gas Cu. Ft.Dry Hole Abandoned

Date

May 17, 1939S. J. Lewis

Scout

Map No. 17 Sec. 31 Twp. 24 R. 13EWell No. 4 PuseyMills Oil


Company

Contractor

CORRECTION

SE SW SE

SECTION PLAT

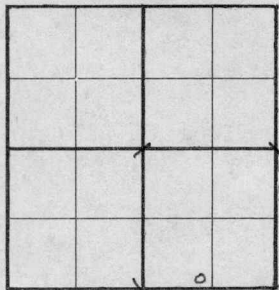 Ft. from N. Line200 Ft. from S. Line Ft. from E. Line800 Ft. from W. Line

Virgil Pool

Location Rig up

Drilling and Remarks:

Change from

Chas. Christy
to Mills Oil

RECORD

Cased in., ft.Sand Gas Oil Total Depth

PRODUCTION

1st 24 hrs. Nat. 1st 24 hrs. after shot Gas Cu. Ft.Dry Hole Abandoned

Date

JUN 10 1939

19

S. J. LEWIS

Scout

Map No. 17 Sec. 31 Twp. 24 R. 13EWell No. 4 PuseyMills Oil

Company _____

Contractor _____

COMPLETED

SE SW SE


_____ Ft. from N. Line

200 Ft. from S. Line

_____ Ft. from E. Line

800 Ft. from W. Line

SECTION PLAT

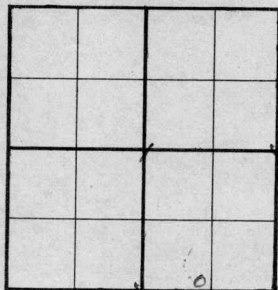

VIRGIL POOL

Location _____

Rig up _____

Drilling and Remarks:

*Bar 81586**P.B. 1549**Shot 409 to 1533-44**6" @ 1526**Pump 8886*

RECORD

Cased _____ in., _____ ft.

Sand _____

Gas _____

Oil _____

Total Depth 1565

PRODUCTION

1st 24 hrs. Nat. _____

1st 24 hrs. after shot _____

Gas _____ Cu. Ft.

Dry Hole _____

Abandoned _____

Date

SEP 27 1939

19

S. J. LEWIS

Scout