


Section 31 Township 24 Range 13EWell No. #1 SchwintzCompany Shira Drlg.

NORTH

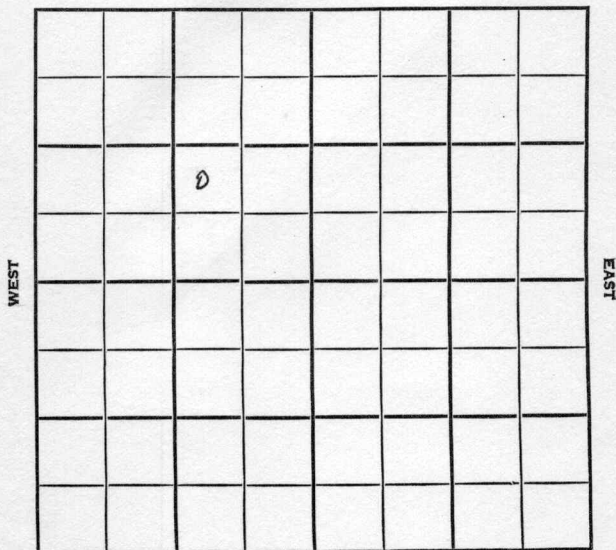

SOUTH

Greenwood KANSAS
SEC. TWP. R.
WELL NO. 31 24 13 E ✓
COMPANY # 1 Schwintz FARM

CONTRACTOR Shira Drlg.

Shira Drlg.
Quincy Pool


Ft. from N. Line

990 Ft. from S. Line

990 Ft. from E. Line

Ft. from W. Line


NW SE NW

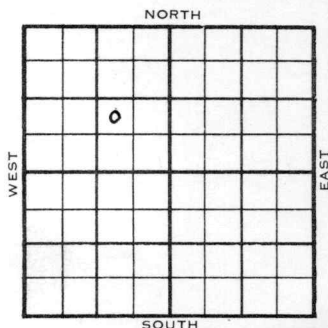

1954 ELEVATION - REPORT

5/12 Spud 5-4-54
Setting prod. string.
7/21 Spud 5-4-54
D&A
TD 1681'
Miss 1651'
TD 1661'
5" @ 1656'
DD 1681 HFW
PB 1668', 500A, HFW
D&A


ABANDONED

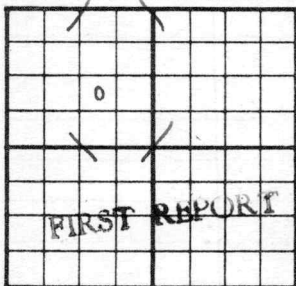County Greenwood State KansasSec. 31 (Blk.) 24 (Sur.) 13E Map No.Operator Shira Drlg.Well No. 1 Farm SchwintzElev. Location NW SE NW990 Ft. From S Line NW990 Ft. From E Line Quarter1st. Report MAY 12 1954

Completion

Remarks

Shira Drlg. - Contr.Spudding Date 5-4-54Drlg. Data Quincy Poolsetting prod. string

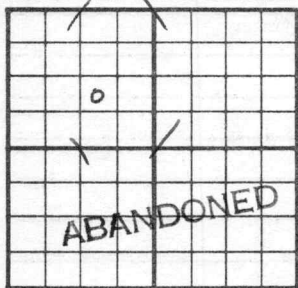County Greenwood State KansasSec. 31 (Blk.
Twp.) 24 (Sur.
Rge.) 13E Map No.Operator Shira Drlg.Well No. 1 Farm SchwintzElev. Location NW SE NW990 Ft. From S Line NW990 Ft. From E Line Quarter

1st. Report

JUL 21 1954

Completion

Remarks Quincy PoolShira Drlg. - Contr.Spudding Date 5-4-54Drlg. Data D & A TD 1681Miss. 1651 TD 1661 5" @ 1656DD 1681 HFW PB 1668 500 A HFWD & A