

Map No. _____ Sec. 3 Twp. 25 R. 9
Well No. 1 Diebert Farm _____
Polhamus Et al Company _____

NORTH

WEST

EAST

SOUTH

FIRST REPORT

Location _____

Drilling Remarks:

Rig up _____

Drilling Remarks:

RECORD

Cased _____ in. _____ ft.

Sand _____

Gas _____

Oil _____

Total Depth _____

PRODUCTION

1st 24 hrs Nat. _____

1st 24 hrs. after shot_____

Gas _____ cu. ft.

Dry Hole_____

Abandoned _____

Map No. _____ Sec. 3 Twp. 25 R. 9


Well No. 1 Dubert Farm _____
Polhamus Etal Company _____

_____ Ft. from N. Line

200 Ft. from S. Line

_____ Ft. from E. Line

200 Ft. from W. Line

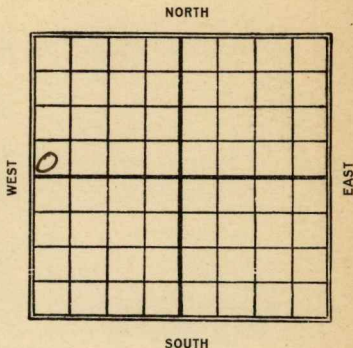

Date
1923

REPORT

1/6 Rig.
3/2 Sand 2219-89-Shot 120
 o/s. 150 Bbs.

KANSAS 15
 Map No. _____ Sec. 3 Twp. 25 R. 9
 Well No. 1 Liebert
Palhamus et al Company
 _____ Contractor

FIRST REPORT

SECTION PLAT

0			

_____ Ft. from N. Line
200 _____ Ft. from S. Line
 _____ Ft. from E. Line
200 _____ Ft. from W. Line

Location _____

Rig up _____

Drilling and Remarks:

RECORD

Cased _____ in., _____ ft.

Sand _____

Gas _____

Oil _____

Total Depth _____

PRODUCTION

1st 24 hrs. Nat. _____

1st 24 hrs. after shot _____

Gas _____ Cu. Ft.

Dry Hole _____

Abandoned _____

Date

JAN 6 1923

M. A. BENEAR

191

Scout

Map No. **KANSAS** ¹⁵ Sec. **3** Twp. **25** R. **9**
 Well No. **1** *Lo-seeport*
Palhamus et al Company

Contractor

COMPLETED**SECTION PLAT**

Ft. from N. Line

200 Ft. from S. Line

Ft. from E. Line

200 Ft. from W. Line

Location

Rig up

Drilling and Remarks:

shot 120/150 ft
RECORD

Cased _____ in., _____ ft.

Sand _____

Gas _____

Oil *2219 - 2289*Total Depth *2289***PRODUCTION**

1st 24 hrs. Nat. _____

1st 24 hrs. after shot _____

Gas _____ Cu. Ft.

Dry Hole _____

Abandoned _____

Date

MAR 2 1923

191

M. A. BENEAR

Scout