


Map No. *KS* Sec. *31* Twp. *24* R. *13*
Well No. *1 Wright* Farm
Chas Christy Company

NORTH

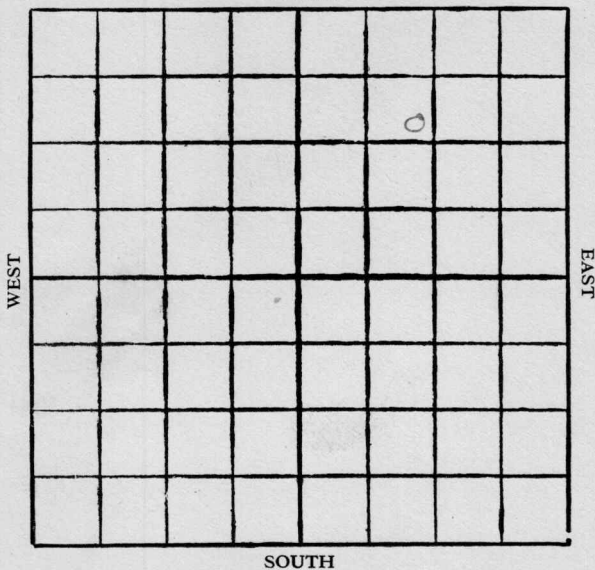

Location _____

Drilling Remarks

Rig Up.....

Drilling Remarks

RECORD

Cased.....in.ft.

Sand

Gas

Oil

Total Depth.....

PRODUCTION

1st 24 hrs. Nat.

1st 24 hrs. after shot.....

Gas..... cu. ft.

Dry Hole

Abandoned -----

Greenwood


Map No. 15 Sec. 31 Twp. 24 R. 13Well No. 17 Wright FarmChas. Christy Company

NORTH

1120 Ft. from N. Line

Ft. from S. Line

Ft. from E. Line

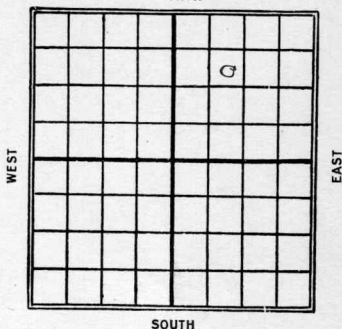1120 Ft. from W. Line

SOUTH

1926

Date

REPORT

11/5	Machine
11/11	Rigging up
11/17	Spudding
11/23	Same
12/8	Drlg 615
12/15	" 1400'
12/22	S. D. 1550
12/30	same
1927	
1/6	no sand, Top line 1620 D. & A. 1664'

nomap
KANSAS
 Map No. *31* Sec. *24* Twp. *13* R. *13*

Well No. *1*
Chas Christy
 _____ Company
 _____ Contractor

SECTION PLAT

1120 _____ Ft. from N. Line

_____ Ft. from S. Line

_____ Ft. from E. Line

1120 _____ Ft. from W. Line

FIRST REPORTS

		0	

Location _____

Rig up *machines* _____

Drilling and Remarks:

RECORD

Cased _____ in., _____ ft.

Sand _____

Gas _____

Oil _____

Total Depth _____

PRODUCTION

1st 24 hrs. Nat. _____

1st 24 hrs. after shot _____

Gas _____ Cu. Ft.

Dry Hole _____

Abandoned _____

Date

NOV 3 1926

CHAS. L. SHERWOOD

Scout

nominal
KANSAS *31* *24* *13*
 Map No. _____ Sec. _____ Twp. _____ R. _____
 Well No. *1 Wright*
Chas Christy _____ Company

_____ Contractor

COMPLETED

SECTION PLAT

1120 _____ Ft. from N. Line
 _____ Ft. from S. Line
 _____ Ft. from E. Line
1120 _____ Ft. from W. Line

		0	

ABANDONED

Location _____
 Rig up _____
 Drilling and Remarks:
no sand
top line 1620
Oil
1664

RECORD

Cased _____ in., _____ ft.
 Sand _____
 Gas _____
 Oil _____
 Total Depth *1664*

PRODUCTION

1st 24 hrs. Nat. _____
 1st 24 hrs. after shot _____
 Gas _____ Cu. Ft.
 Dry Hole *✓*
 Abandoned *✓*

Date
 JAN 6 1927

CHAS. L. SHERWOOD