
DX 78-1 Rice KANSAS

Section 5 Township 21 S Range 6 W

Well No. #1 Renollett "X" "B"

Company H. O. Bennett

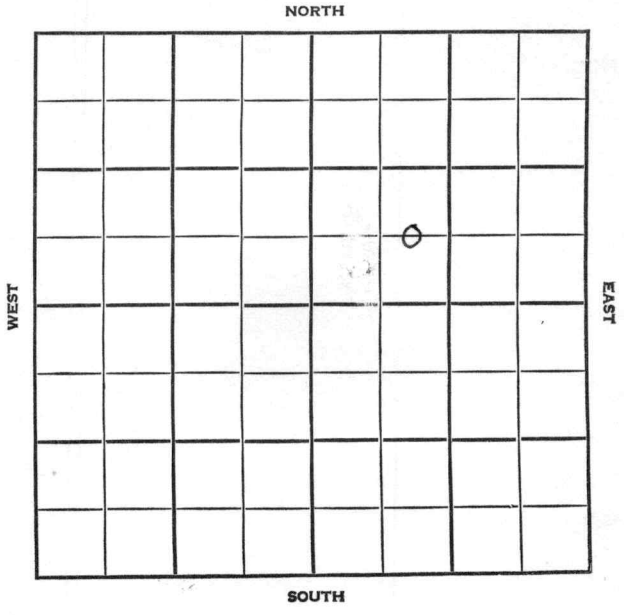

Rice KANSAS

SEC.	TWP.	R.
5	21S	6W

WELL NO. #1 Renollett ~~"A"~~ "B" FARM

COMPANY H. C. Bennett

CONTRACTOR Salina


Selch-Bornholt

1900 Ft. from N. Line

Ft. from S. Line

1600 Ft. from E. Line

Ft. from W. Line

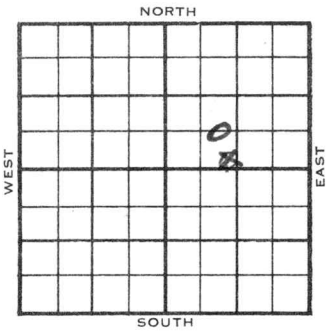

E½ SW NE

1955	ELEVATION 1648'	REPORT
9/28	8" @ 171 w/150 D 2100	
11/2	8" @ 171 5 1/2" @ 3450 H 2691 Tr 2709 Dodge 2714 Shly 3405 Ch Cong 3427 M 3449 TD 3451 DD 3470 S/35 bo 12 hr. Comp 45 bopd 3 bw	

COMPLETED

DX-78

FORM 513 REV. SUNRAY

County Rice Elev. 1648

Sec. 5 Twp. 21 Rge. 6W

Company H. C. Bennett

Farm Name Renollett "B" No. 1

TOPS	DEPTH	LOG	DATUM
Anh.			
Tp.			
H.	2691		1043
Tr.	2709		1061
Dg. Dodge	2714		1066
B.L.			
L.			
K.C.			
B.K.C.			
Ce.			
C. Shale	3405		1757
M. Ch. Conglg	3427		1779
M.	3449		1801
K.			
Mz.			
Mq.			
V.			
S.			
S.			
A			
R.			
P€.			
G.			
T.D.	3451		

Loc. in Sec. E½ SW NE

1900' NL

1600' EL

Geol.

Contr. Salina

Pool Welch-Bornholt

COMPLETE

Date Comm. NOV 2 1955

8" @ 171 5½" @ 3450 DD 3470

S/ 35 bo 12 hr. Comp. 45 bopd 3 bw

Co. Lse. No. Sec. T. R.

SCOUT TICKET DX-201

SEC.	TWP.	R.
5	21	6W

WELL NO.

1 Renollett "B" FARM

COMPANY

H. C. Bennett

CONTRACTOR

CORRECTION


E½ SW NE

1900 FT. FROM N. LINE

FT. FROM S. LINE

1600 FT. FORM E. LINE

FT. FROM W. LINE

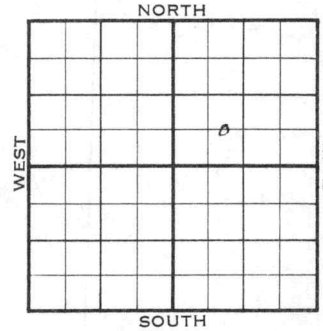

Rice County

☐ LOCATION

☐ RIG UP

DRILLING AND REMARKS:

Reported
#1 Renollett "A"

RECORD

CASED IN., FT.
SAND
GAS
OIL
TOTAL DEPTH

PRODUCTION

1ST 24 HRS. NAT.
1ST 24 HRS. AFTER SHOT
GAS CU. FT.
DRY HOLE
ABANDONED

DATE

OCT 5 1955

SCOUT

L. J. Harris

FORM 513 REV. SUNRAY

County Rice Elev. 1648 DF

Sec. 5 Twp. 21S Rge. 6W

Company H. C. Bennett

Farm Name Renollett "A" No. 1

"A" Lease SW NE

TOPS	DEPTH	LOG	DATUM
Anh.			
Tp.			
H.			
Tr.			
Dg.			
B.L.			
L.			
K.C.			
B.K.C.			
Ce.			
C.			
M.			
M.			
K.			
Mz.			
Mo.			
V.			
S.			
S.			
A			
R.			
P€.			
G.			
T.D.			

Loc. in Sec. E½ SW NE 1900' FNL x ~~1600' FEL~~ of Sec.

Geol.

Contr. Salina

Pool Welch Bornholt

FIRST REPORT

Date Comm. SEP 28 1955

8" 171 w/150; D 2100

Co. Lse. No. Sec. T. R.