DX 78-1


Rice

KANSAS

Section 5 Township 21 Range 6W

Well No. 1 Renolett "B"

Company H. C. Bennett

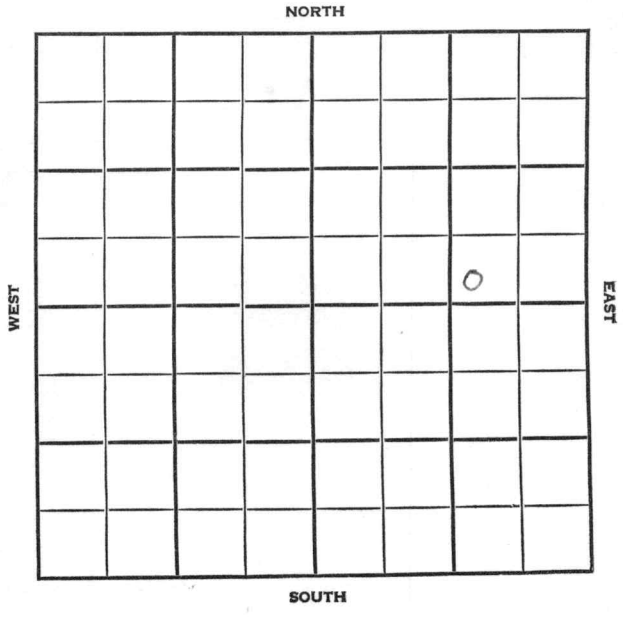

Rice KANSAS

SEC.	TWP.	R.
5	21S	6W

WELL NO.
#1 Renollet "B" FARM

COMPANY
H. C. Bennett

CONTRACTOR
Salina

Welsh


_____ Ft. from N. Line

_____ Ft. from S. Line

_____ Ft. from E. Line

_____ Ft. from W. Line

SW SE NE

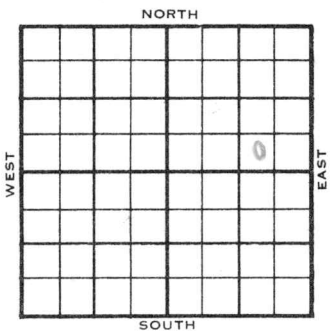

1955 ELEVATION 1650' REPORT

7/20 MIRT

9-15 Comm. 7-19-55
8 5/8"
RTD 3454;
5" 3452;
Swb ½ boph plus 25% wtr.;
Swb ½ boph plus 10% wtr.
frac; pmp 30 bopd 10% wtr.

TOPS	DEPTH
H.	2687
Tr.	2707
L.	2906
C.	3431
M.	3451

T.D. 3454'

COMPLETED

DX-78

FORM 513 REV. SUNRAY

County Rice Elev.

Sec. 5 Twp. 21S Rge. 6W

Company H. C. Bennett

Farm Name Renollet "B" No. 1

TOPS	DEPTH	LOG	DATUM
Anh.			
T.P.			
H.			
Tr.			
Dg.			
B.L.			
L.			
K.C.			
B.K.C.			
Ce.			
C.			
M.			
M.			
K.			
Mz.			
Mq.			
V.			
S.			
S.			
A			
R.			
P€.			
G.			
T.D.			

Loc. in Sec. SW SE NE

Geol.

Contr. Salina

Pool Welch

FIRST REPORT

JUL 20 '54

Date Comm. MIRT

12

Co. Lse. No. Sec. T. R.

FORM 513 REV. SUNRAY

County Rice Elev. 1650

Sec. 5 Twp. 21S Rge. 6W

Company H. C. Bennett

Farm Name Renollet "B" No. 1

TOPS	DEPTH	LOG	DATUM
Anh.			
T.P.	2687		1037
H.	2707		1057
Tr.			
Dg.			
B.L.	2906		1256
L.			
K.C.			
B.K.C.			
Ce.			
C.	3431		1781
M.	3451		1801
M.			
K.			
Mz.			
Mo.			
V.			
S.			
S.			
A			
R.			
P€.			
G.			
T.D.	3454		

Loc. in Sec. SW SE NE

Geol.

Contr. Salina

Pool Welch

COMPLETE

Date Comm. 7-19-55

SEP 1 4 1955

set 8-5/8"; RTD 3454; 5" 3452; swb 1/2 boph plus 25% wtr.; swb 1/2 boph plus 10% wtr.; frac; pmp 30 bopd 10% wtr.

Co. Lse. No. Sec. T. R.