


FORM 51 Rice

KANSAS

Section 5 Township 21 Range 6W

Well No. 9 #5 Renollet

Company Henry Bennett

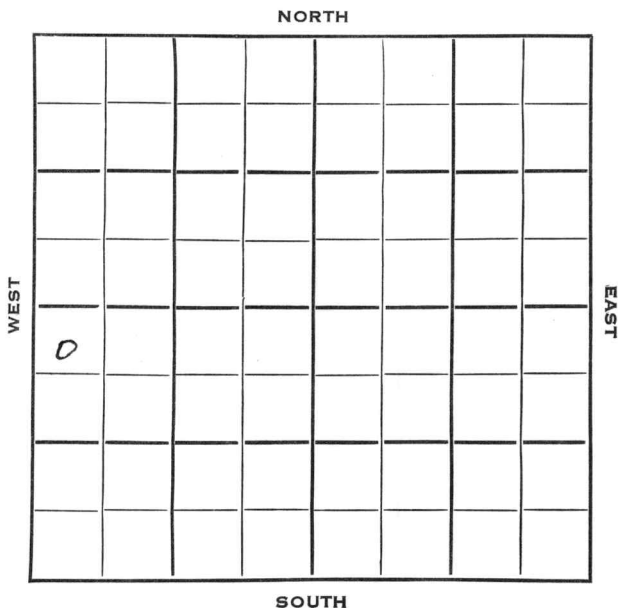

Rice

KANSAS



Sec. 5 Twp. 21 R. 6W

Well No. #5 ~~#1~~ Renollet Farm

Henry Bennett Company

Mallard Drlg. Contractor


330 Ft. from N. Line

_____ Ft. from S. Line

_____ Ft. from E. Line

330 Ft. from W. Line

NW NWSW

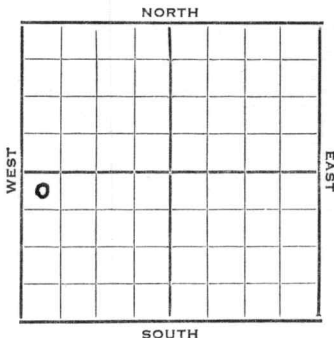

1952 Elev. 1680' REPORT

12/10 RUR

12/11 RUR

12/18 Ø1711

12/25 Drlg 1711

1/1 Miss 3469 RTD 3473 5" @ 3470

1/8 NR

1/22 NR

1/29 NR

2/5 "

2/12 DD 3484

FU 500' oil, Hyd

2/18 Spud 12-12-52

Oil well TD 3484' 8" @ 145

Miss 3469' TD 3473 5" @ 3470

DD 3484 FU 500' oil Hydro

Comp. 60 BOPD

COMPLETED

Map No. _____ Sec. 5 Twp. 21 R. 6WWell No. 5 Renollet

_____ Henry Bennett _____ Company

_____ CORRECTION _____ Contractor

NW NW SW

SECTION PLAT

330 _____ Ft. from N. Line

_____ Ft. from S. Line

_____ Ft. from E. Line

330 _____ Ft. from W. Line

o			

Rice County

Location _____

Rig up _____

Drilling and Remarks:

Reported

#1 Renollet

RECORD

Cased _____ in., _____ ft.

Sand _____

Gas _____

Oil _____

Total Depth _____

PRODUCTION

1st 24 hrs. Nat. _____

1st 24 hrs. after shot _____

Gas _____ Cu. Ft.

Dry Hole _____

Abandoned _____

Date

DEC 23 1952 19

J. G. McGEHEE

Scout

J. G. McGEHEE