


Section 5 Township 21 Range 6W

Well No. #2 Renollet

Company Cities Service Oil

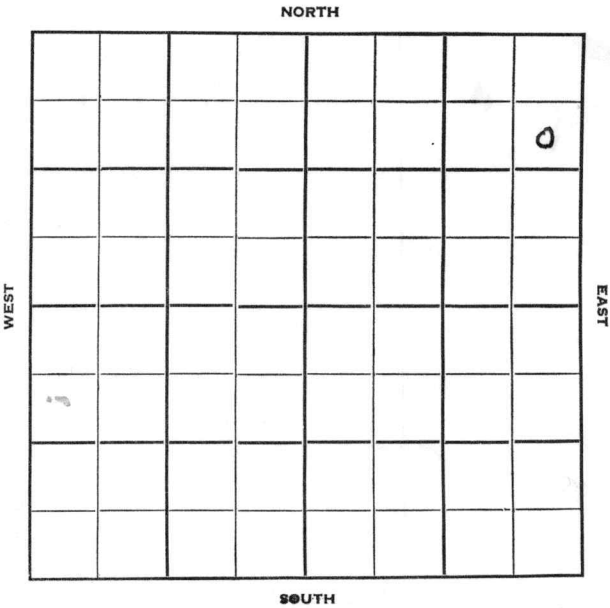

Sec. 5 Twp. 21 R. 6W

Well No. #2 Renollet Farm

Cities Service Oil Company

Lohman & Johnson Contractor


990 Ft. from N. Line

_____ Ft. from S. Line

330 Ft. from E. Line

_____ Ft. from W. Line

SE NE NE

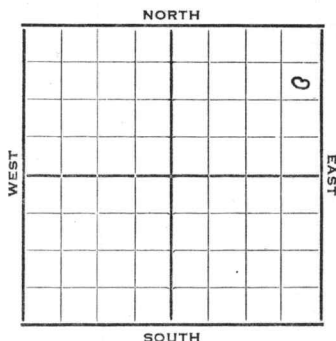

1952

REPORT

6/25 Spud 6-22-52
8" @ 263'
Drlg.

7/2 Drlg. 3000'

7/9 Lans. 2896' Cong. 3385' Miss 3418'
RTD 3425' 5" @ 3421 TD 3447'
45' oil 1 hr.

7/17 P/3 BO Sand frac.
P/198 BOPD

7/23 P/ 38 Bo 4 hrs.

7/30 NR

8/6 NR

8/13 "

8/20 "


8/27 Spud 6-22-52
Oil Well TD 3447'
8" @ 263'
Lans. 3896 Cong. 3385
Miss 3418
TD 3425
5" @ 3421 DD 3447 FU 45' oil
1 hr. P/ 3 bo Sd-Frac P/ 198
bo 24 hr. P/ 38 bo 4 hr.
Comp. 100 bopd

COMPLETED

County Rice State Kansas
 (Blk.) (Sur.)
 Sec. 5 21 6W Map No.

Operator Cities Service Oil
 Well No. 2 Farm Renollet

Elev. Location SE NE NE

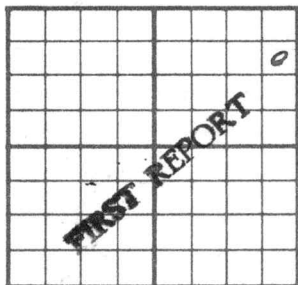

990 Ft. From K Line NE
330 Ft. From E Line Quarter

1st. Report JUN 25 1952

Completion

Remarks


Lohman & Johnson

Spudding Date 6-22-52

Drlg. Data
8" @ 263 Drlg.

J. G. McGEHEE

County Rice State Kan
 Sec. 5 (Blk.) 21 (Sur.) 6W Map No. 1828
 Operator Cities Service Oil
 Well No. 2 Farm Renollet
 Elev. 1634 Location SE NE NE

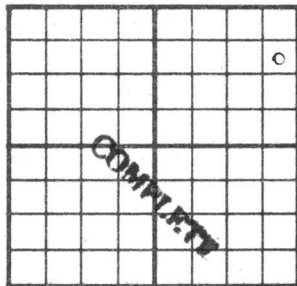

990 Ft. From N Line NE
330 Ft. From E Line Quarter

1st. Report

Completion AUG 27 1952

Remarks

Lohman & Johnson - Contr

Spudding Date 6-22-52

Drlg. Data Oil well TD 3447

8" @ 263 Lans. 2896 Cong. 3385

Miss. 3418 TD 3425 5" @ 3421 DD 3447

FU 45' oil 1 hr. P/ 3 bo Sd-Frac

P/ 198 bo 24 hr. P/ 38 bo 4 hr.

Comp. 100 bopd

J. G. McGEHEE