


Map No. Kan Sec. 3 Twp. 25 R. 9
Well No. 7 Robert Farm
Mid-Kansas Company

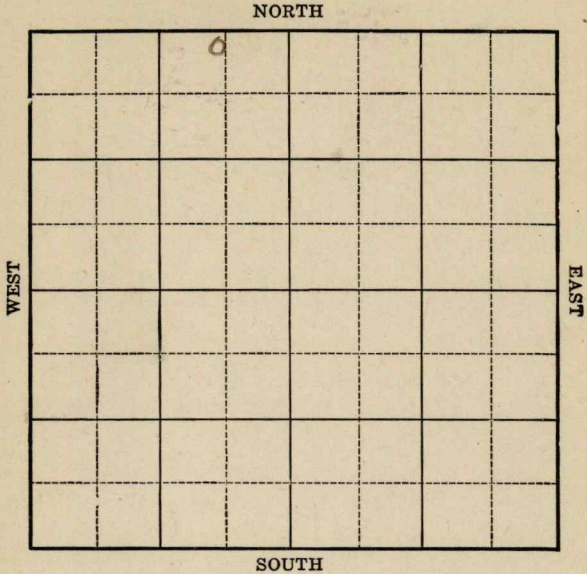

Location _____
Drilling Remarks _____

Rig Up _____
Drilling Remarks _____

RECORD

Cased _____ in. _____ ft.
Sand _____
Gas _____
Oil _____
Total Depth _____

PRODUCTION

1st 24 hrs. Nat. _____
1st. 24 hrs. after shot _____
Gas _____ cu. ft.
Dry Hole _____
Abandoned _____


Map No. Kan Sec. 3 Twp. 25 R. 9Well No. 7 Obert FarmMid Kansas Company200 Ft. from N. Line

Ft. from S. Line

775 Ft. from E. Line

Ft. from W. Line

C

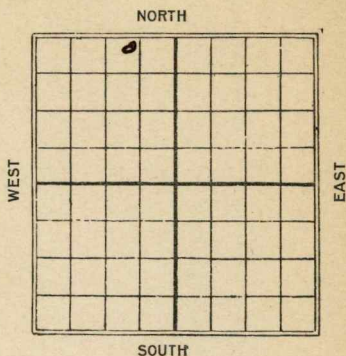

Date	REPORT
<u>1925</u>	
<u>7/3</u>	<u>Location</u>
<u>7/10</u>	<u>Bldg rig</u>
<u>7/17</u>	<u>Rig</u>
<u>7/24</u>	<u>Spudding.</u>
<u>7/31</u>	<u>400'</u>
<u>8/7</u>	<u>800'</u>
<u>8/14</u>	<u>1300'</u>
<u>8/20</u>	<u>1800'</u>
<u>8/27</u>	<u>1950'</u>
<u>9/3</u>	<u>Shut 2182-2249</u> <u>200 gts 100 Bbls</u>

Map No. 15 Sec. 3 Twp. 25 R. 9

Well No. 7 SIBERT

Mid-Kansas Company

Contractor

FIRST REPORTS

SECTION PLAT

200 Ft. from N. Line

_____ Ft. from S. Line

775 Ft. from E. Line

_____ Ft. from W. Line

	0		

Location ✓

Rig up _____

Drilling and Remarks:

RECORD

Cased _____ in., _____ ft.

Sand _____

Gas _____

Oil _____

Total Depth _____

PRODUCTION

1st 24 hrs. Nat. _____

1st 24 hrs. after shot _____

Gas _____ Cu. Ft.

Dry Hole _____

Abandoned _____

Date

JUL 3

1925

CHAS. L. SHERWOOD

192

Scout

Greenwood Co

Map No. KANSAS Sec. 3 Twp. 25 R. 9Well No. 7 Dibert
Mid-Kansas Company

Contractor

COMPLETED

SECTION PLAT

200 Ft. from N. Line

Ft. from S. Line

775 Ft. from E. Line

Ft. from W. Line

	8		

Location

Rig up

Drilling and Remarks:

RECORD

Cased 182 in., vr49 ft.

Sand

Gas

Oil

Total Depth vr49'

PRODUCTION

1st 24 hrs. Nat.

1st 24 hrs. after shot

Gas Cu. Ft.

Dry Hole

Abandoned

Date

SEP 3 1925

192

CHAS. L. SHERWOOD

Scout

200/100 bks.