

KANSAS Butler


Section 11 Township 25 Range 3E

Well No. 1 Moore

Company Wixon & Eldorado

Misc.

NORTH

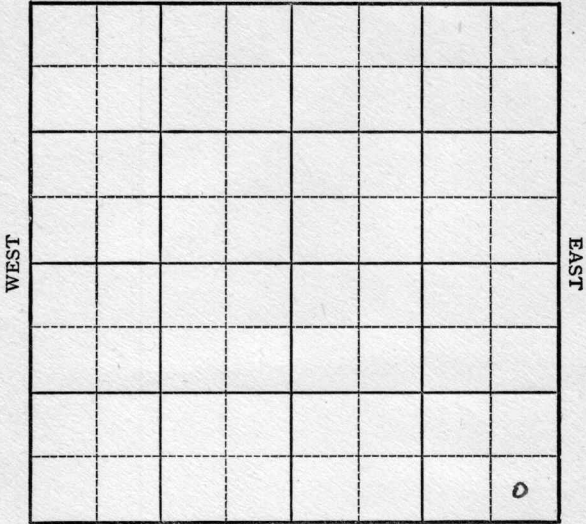

SOUTH

KANSAS

Butler

Sec. 11 Twp. 25 R. 3E ✓

Well No. #1 Moore Farm

Wixson & Eldorado Company

Miscellaneous


_____ Ft. from N. Line

330' Ft. from S. Line

330' Ft. from E. Line

_____ Ft. from W. Line

SE/C

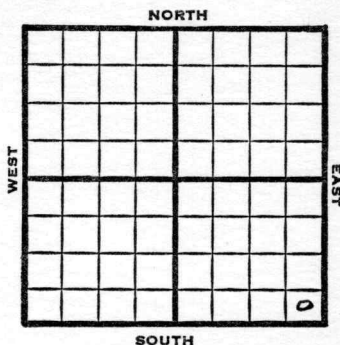

1949

Elev 1312'

REPORT

- 3/30 Location
- 4/6 Mach.
- 4/12 "
- 4/20 Drlg. 740'
- 4/27 Drlg. 1415'
- 5/4 10" @ 1415'
Lansing 1965'
Drlg. 2045'
- 5/10 8" @ 234'
KC 2240'
Miss 2692
TD 2697'
- 5/18 5" @ 2692'
TD 2790'
Miss 2692'
Aband.

ABANDONED

Map No. _____ Sec. 11 Twp. 25 R. 3E

Well No. 1 Moore

Wixson & Eldorado Company

FIRST REPORT

Contractor

SE/C

SECTION PLAT

_____ Ft. from N. Line

330 Ft. from S. Line

330 Ft. from E. Line

_____ Ft. from W. Line

Butler County

Location X

Rig up _____

Drilling and Remarks:

RECORD

Cased _____ in., _____ ft.

Sand _____

Gas _____

Oil _____

Total Depth _____

PRODUCTION

1st 24 hrs. Nat. _____

1st 24 hrs. after shot _____

Gas _____ Cu. Ft.

Dry Hole _____

Abandoned _____

Date

MAR 30 1949 19

S. J. LEWIS Scout

Map No. K13 Sec. 11 Twp. 25 R. 3E

Well No. 1 Moore

Wixson & Eldorado Company

ABANDONED

Contractor

SE/C

E. 1, 1912
SECTION PLAT

_____ Ft. from N. Line

330 Ft. from S. Line

330 Ft. from E. Line

_____ Ft. from W. Line

Butler County

Location _____

Rig up _____

Drilling and Remarks:

Moore 2692

RECORD

Cased _____ in., _____ ft.

Sand _____

Gas _____

Oil _____

Total Depth 2790

PRODUCTION

1st 24 hrs. Nat. _____

1st 24 hrs. after shot _____

Gas _____ Cu. Ft.

Dry Hole _____

Abandoned _____

Date

MAY 18 1949

19

S. J. LEWIS

Scout