


Company H. C. Bennett

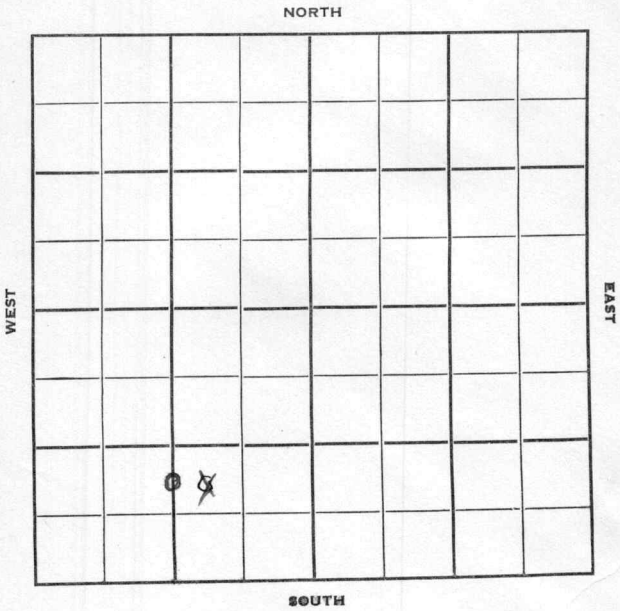

Rice

KANSAS

Sec. 5 Twp. 21 R. 6 W ✓

Well No. # 4 Renollet Farm

H. C. Bennett Company

Mallard Drlg. Contractor

Welsh Pool

Ft. from N. Line

990

Ft. from S. Line

950

1350


Ft. from E. Line

990

Ft. from W. Line

~~NW SE SW~~

C NL  $5\frac{1}{2}$  SW

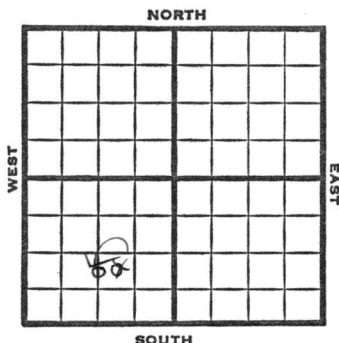

1951

Elev. 1678' REPORT

8/8

R U R

9/19

Spud 8-9-51  
Oil Well TD 3512  
8" @ 126  
Miss 3482-84  
5" @ 3482  
TD 3512 B/1 boph  
Comp. 15 bopd

**COMPLETED**

|        |      |       |        |
|--------|------|-------|--------|
| County | Rice | State | Kansas |
|--------|------|-------|--------|

Sec. 5 (Blk. Twp.) 21 (Sur. Rge.) 6W Map No.

Operator H. C. Bennett

Well No. 4 Farm Renollet

|       |      |          |                          |
|-------|------|----------|--------------------------|
| Elev. | 1678 | Location | C N L S $\frac{1}{2}$ SW |
|-------|------|----------|--------------------------|

COMPLETE

0

990 Ft. From S Line SW

1320 Ft. From E Line Quarter

1st. Report

Completion SEP 19 1951

|         |            |
|---------|------------|
| Remarks | Welsh Pool |
|---------|------------|

Mallard Drlg. - Contr.

Spudding Date 8-9-51

Drilg. Data      Oil well      TD 3512

8" @ 126 Miss. 3482-84 5" @ 3482

TD 3512 B/ 1 boph Comp. 15 bopd

J. E. TYRA

County Rice State Kansas

Sec. 5 (Blk. Twp.) 21 (Sur. Rge.) 6W Map No.

Operator H. C. Bennett

Well No. **4** Farm **Renollet**

[illegible]

**FIRST REPORT**

950 Ft. From S Line SW

990 Ft. From E Line Quarter

1st. Report      AUG      8   1951

### Completion

Remarks

Mallard Drlg. - Contr.

Spudding Date \_\_\_\_\_

Drlg. Data Welsh Pool

R U R

J. E. TYRA

Kansas

Map No. \_\_\_\_\_ Sec. 5 Twp. 21 R. 6W

Well No. 4 Renollet

H. C. Bennett

Company

Contractor

C N L S  $\frac{1}{2}$  SW

SECTION PLAT



\_\_\_\_\_ Ft. from N. Line

990 Ft. from S. Line

1320 Ft. from E. Line

\_\_\_\_\_ Ft. from W. Line

Rice County

Location \_\_\_\_\_

Rig up \_\_\_\_\_

Drilling and Remarks:

Reported

NW SE SW

RECORD

Cased \_\_\_\_\_ in., \_\_\_\_\_ ft.

Sand \_\_\_\_\_

Gas \_\_\_\_\_

Oil \_\_\_\_\_

Total Depth \_\_\_\_\_

PRODUCTION

1st 24 hrs. Nat. \_\_\_\_\_

1st 24 hrs. after shot \_\_\_\_\_

Gas \_\_\_\_\_ Cu. Ft.

Dry Hole \_\_\_\_\_

Abandoned \_\_\_\_\_

195

19

J. E. TYRA

Scout