


Butler

Section 11 Township 25 Range 3-E

Well No. 4 Dohren

Company Wixson et al

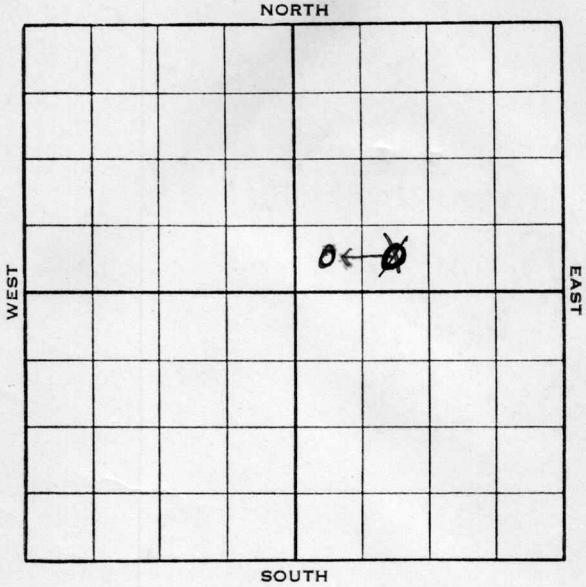

Sec. 11 Twp. 25 R. 3-E

Well No. #4 Dohran Farm _____
Wixson et al Company _____


_____ Ft. from N. Line

330 Ft. from S. Line

_____ Ft. from E. Line

330
~~900~~ Ft. from W. Line

Elev. 1305

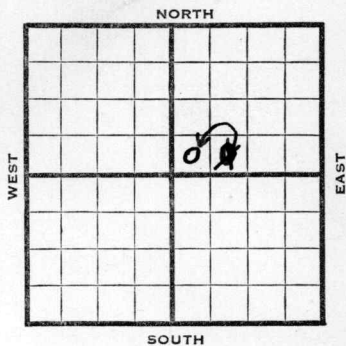

1938	REPORT
3/23	Mach.
4/1	"
4/8	12" @ 68'. Drlg. 600'.
4/15	10" @ 1218'. Drlg. 1278'.
4/22	8" @ 2011'. Drlg. 2125'.
4/29	5" @ 2683'. WOC.
5/4	5" @ 2683'.
	Miss. 2678'.
	T.D. 2691'.
	3000 acid.
	Potential 80 bbls.
	COMPLETED

Map No. 13 Sec. 11 Twp. 25 R. 3E

Well No. 4 Dohran

Wixson ET al Company

Contractor

FIRST REPORT

SECTION PLAT

SE SW NE

_____ Ft. from N. Line

330 Ft. from S. Line

_____ Ft. from E. Line

990 Ft. from W. Line

		0	

Location _____

Rig up _____

Drilling and Remarks:

Mach.

RECORD

Cased _____ in., _____ ft.

Sand _____

Gas _____

Oil _____

Total Depth _____

PRODUCTION

1st 24 hrs. Nat. _____

1st 24 hrs. after shot _____

Gas _____ Cu. Ft.

Dry Hole _____

Abandoned _____

Date

MAR 23 1938

19

H. D. Hatfield Scout

Butler KANSAS

Map No. _____ Sec. 11 Twp. 25 R. 3E

Well No. H Dohan

Wisson Company

Contractor

CORRECTION

sw. NE

SECTION PLAT

		0	

_____ Ft. from N. Line

330 Ft. from S. Line

_____ Ft. from E. Line

330 Ft. from W. Line

CORRECTION

RECORD

Location _____

Cased _____ in., _____ ft.

Rig up _____

Sand _____

Drilling and Remarks:

Gas _____

Oil _____

Total Depth _____

PRODUCTION

1st 24 hrs. Nat. _____

1st 24 hrs. after shot _____

Gas _____ Cu. Ft.

Dry Hole _____

Abandoned _____

*first reported
as se sw ne
corrected to
sw ne*

Date

MAY 4 - 1938 19

H. D. Hatfield Scout

Butler KANSAS

Map No. 13 Sec. 11 Twp. 25 R. 3E

Well No. 4 Dohran

Wixson

Company

COMPLETED

Contractor

SW NE

SECTION PLAT

Corrected From

~~SE SW NE~~

Ft. from N. Line

330

Ft. from S. Line

Ft. from E. Line

~~330~~
~~990~~

Ft. from W. Line

		0	

Location _____

RECORD

Cased 5 in., 2683 ft.

Rig up _____

Sand MISS 2678

Drilling and Remarks:

Gas _____

3000 Acid

Oil _____

POT 80

Total Depth 2691

PRODUCTION

1st 24 hrs. Nat. _____

1st 24 hrs. after shot _____

Gas _____ Cu. Ft.

Dry Hole _____

Abandoned _____

Date

MAY 4 - 1938

19

H. D. Hatfield Scout