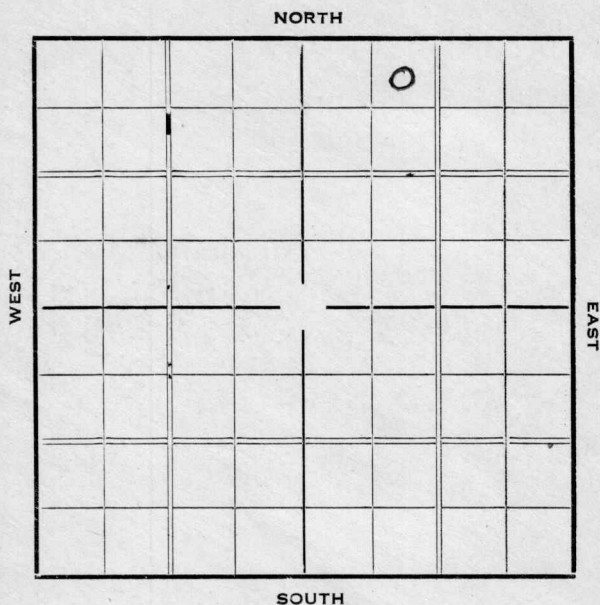


Section 12 Township 25 Range 3EWell Number 2 HoustonCompany Sheldon & Wixon

Sec. 12 Twp. 25 R. 3-E

Well No. 2 Houston Farm

Sheldon & Hixson Company


330 Ft. from N. Line

_____Ft. from S. Line

_____Ft. from E. Line

990 Ft. from W. Line

Elev. 1294

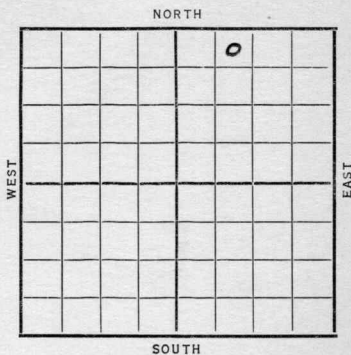[illegible]

KANSAS

Map No. 13 Sec. 12 Twp. 25 R. 2E

Well No. 2 Houston

Shelton & Hixson Company

Contractor

SECTION PLAT

330 Ft. from N. Line

_____ Ft. from S. Line

_____ Ft. from E. Line

990 Ft. from W. Line

FIRST REPORT

Location _____

Rig up _____

Drilling and Remarks:

Rigging up

RECORD

Cased _____ in., _____ ft.

Sand _____

Gas _____

Oil _____

Total Depth _____

PRODUCTION

1st 24 hrs. Nat. _____

1st 24 hrs. after shot _____

Gas _____ Cu. Ft.

Dry Hole _____

Abandoned _____

Date

NOV 10 1936

19

S. J. LEWIS

Scout

KANSAS

Map No. 39 Sec. 12 Twp. 25 R. 3E

Well No. 2 Houston

Shelton & Hixson Company

Contractor

SECTION PLAT

330 Ft. from N. Line

_____ Ft. from S. Line

_____ Ft. from E. Line

990 Ft. from W. Line

COMPLETED

		0	

Location _____

Rig up _____

Drilling and Remarks:

Miss L 2655
2000 acid
P 8521

RECORD

Cased _____ in., _____ ft.

Sand _____

Gas _____

Oil _____

Total Depth 2674

PRODUCTION

1st 24 hrs. Nat. _____

1st 24 hrs. after shot _____

Gas _____ Cu. Ft.

Dry Hole _____

Abandoned _____

Date

JAN 6 1937 19

S. J. LEWIS Scout