

Map No. _____ Sec. 4 Twp. 25 R. 9
Well No. 2 Dunlaps _____ Farm
Rogers _____ Company

NORTH

WEST

EAST

SOUTH

Location _____

Drilling Remarks:

Rig up _____

Drilling Remarks:

RECORD

Cased _____ in. _____ ft.

Sand _____

Gas _____

Oil _____

Total Depth _____

PRODUCTION

1st 24 hrs Nat. _____

1st 24 hrs. after shot_____

Gas _____ cu. ft.

Dry Hole_____

Abandoned _____

Map No. _____ Sec. 4 Twp. 25 R. 9


Well No. 2 Dunlap Farm _____
Rogers Company _____

200 Ft. from N. Line

_____ Ft. from S. Line

660 Ft. from E. Line

_____ Ft. from W. Line

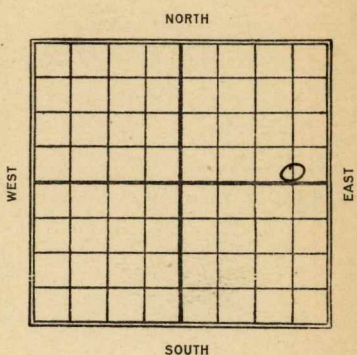

Date	REPORT
1923	
1/12	Rig.
5/7	Sand 2200-95-Shot
	80 gts. 160 Bbls.

Map No. ¹⁵~~KAUBER~~ Sec. ⁴ Twp. ²⁵ R. ⁹

Well No. ² *200m lap*

Rogers Company

Contractor

SECTION PLAT

FIRST REPORT

200 Ft. from N. Line

_____ Ft. from S. Line

600 Ft. from E. Line

_____ Ft. from W. Line

			o

RECORD

Location _____

Rig up *✓✓*

Drilling and Remarks:

Cased _____ in., _____ ft.

Sand _____

Gas _____

Oil _____

Total Depth _____

PRODUCTION

1st 24 hrs. Nat. _____

1st 24 hrs. after shot _____

Gas _____ Cu. Ft.

Dry Hole _____

Abandoned _____

Date *JAN 12 1923*

Map No. ~~14820~~ ¹⁵ Sec. 4 Twp. 23 R. 9Well No. 2 HayleyRaggers et al Company

Contractor

COMPLETED**SECTION PLAT**

Ft. from N. Line

200

Ft. from S. Line

660

Ft. from E. Line

Ft. from W. Line

			0

RECORD

Location

Rig up

Drilling and Remarks:

2 and (2200)
(2293)80/160 bbls

Cased in., ft.

Sand

Gas

Oil

Total Depth

PRODUCTION

1st 24 hrs. Nat.

1st 24 hrs. after shot

Gas Cu. Ft.

Dry Hole

Abandoned

Date

MAY 7 1923

M. A. BENEAR

191

Scout