

Section 25 Township 20 Range 14 W

Well No. # 1 Davis

Company Hinkle Oil

NORTH

0							

WEST

EAST

SOUTH

Sec. 25 Twp. 20 R. 14W

Well No. #1 Davis Farm

Hinkle Oil Company

NW Hiss Pool Contractor


Ft. from N. Line

330' Ft. from S. Line

Ft. from E. Line

330' Ft. from W. Line

SW SW SW

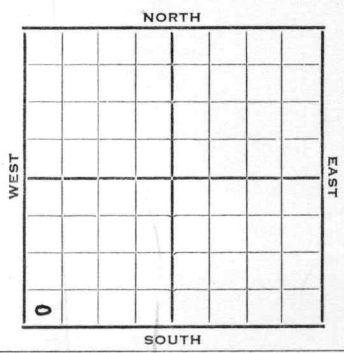

1952	Elev. 1905'	REPORT
3/12	Spud 3-5-52 8" @ 815 Drlg. 2420'	
3/19	Heeb. 3171 Lans. 3270 DST 3264-94 1 hr. 60' GCM 1042# 20" 1052# 20" Cong. 3516 Arb. 3544 TD 3580 5" @ 3580	Br Li 3263
3/25	NR	
4/1	24/3544-50, 1/2 BOPH, 500 A 3-4 BOPH Strato-frac 16 BOPH for 5 hrs POP	
4/9	"	
4/16	Spud 3-5-52 Oil Well TD 3580 8" @ 815 Heeb. 3171 Lans. 3270 DST 3264-94 open 1 hr. rec. 60' gcm DST 3299-3350 open 1 hr. rec. 80' o&gcm 270' muddy gassy oil 180' clean oil DST 3404-70 open 1 hr. rec. 30' so&gcm 90' oily mud 90' gassy mud 180' clean oil Cong. 3516 ReArb. 3526 Arb. 3544 TD 3580 5" @ 3580 24/ 3544-50 1/2 boph 500 A 3 to 4 boph Stratolift 16 boph 5 hr. Comp. 290 bopd 20% wtr.	

COMPLETED OVER

1953
2/18

O. W. P. B.

Oil well TD 3580' Lans. 3270'
Arb. 3526' 5" @ 3580 OTD 3580
SP 3500 12/3459-63 25/3437-45
500 A S/wtr. SP 3450
25/3433-41 30/3425-34 500 A
S/11 BOPH
Comp. 25 BOPD

FIRST REPORT

✓


COMPLETED

County **Barton** State **KANSAS**
Sec. **25** (Blk.) **20** (Sur.) **14W** Map No.

Operator **Hinkle Oil**

Well No. **1** Farm **Davis**

Elev. Location **SW SW SW**

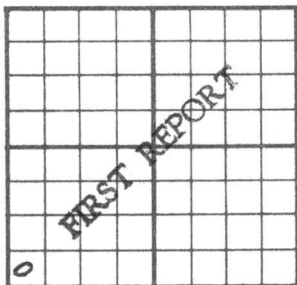

330 Ft. From **S** Line **SW**

330 Ft. From **W** Line Quarter

1st. Report **MAR 1 2 1952**

Completion


Remarks **Phillips DHM**

Spudding Date **3-5-52**

Drlg. Data **NW Hiss Pool**

8" @ 815 drlg. 2420

J. G. McGEHEE

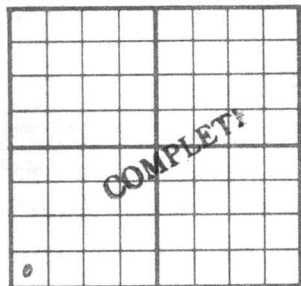County **Barton** State **Kansas**Sec. **25** (Blk. Twp.) **20** (Sur. Rge.) **14W** Map No.Operator **Hinkle Oil**Well No. **1** Farm **Davis**Elev. **1905** Location **SW SW SW****330** Ft. From **S** Line **SW****330** Ft. From **W** Line **Quarter**

1st. Report

Completion **APR 16 1952**Remarks **NW Hiss Pool**Spudding Date **3-5-52**Drlg. Data **Oil well** **TD 3580****8" @ 815 Heeb. 3171 Br. lime 3263****Lans. 3270 DST 3264-94 open 1 hr.****Rec. 60' gcm DST 3299-3350 open 1 hr.****Rec. 80' o & gcm 270' muddy gassy oil****180' clean oil DST 3404-70 open 1 hr.****Rec. 30' so & gcm 90' oily mud 90'****gassy mud 180' clean oil Cong. 3516****ReArb. 3526 Arb. 3544 TD 3580****5" @ 3580 24/ 3544-50 $\frac{1}{2}$ boph 500 A****3 to 4 boph stratolift 16 boph 5 hr.****Comp. 290 bopd 20% water****J. G. McGEHEE**

J. G. McGEHEE