


Section 4 Township 21 Range 6W

Well No. #5 Clevinger

Company Seegar & Sterling

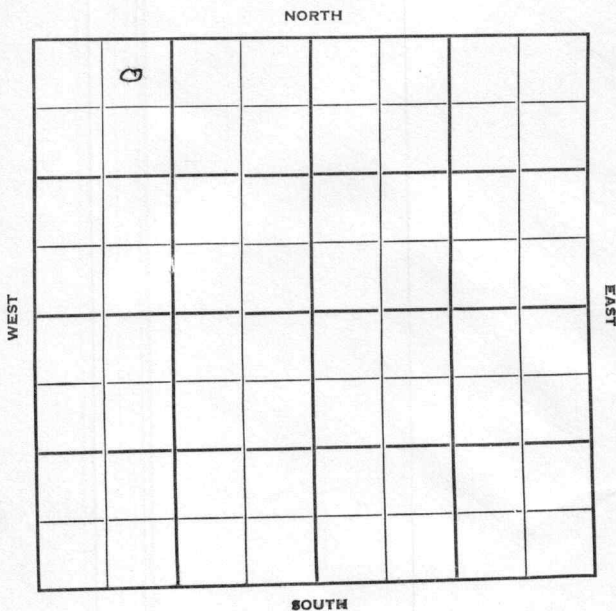

Rice KANSAS

Sec. 4 Twp. 21 R. 6 W

Well No. # 5 Clevinger Farm

Seegar & Sterling Company

Contractor


330 Ft. from N. Line

Ft. from S. Line

Ft. from E. Line

990 Ft. from W. Line

NE NW NW

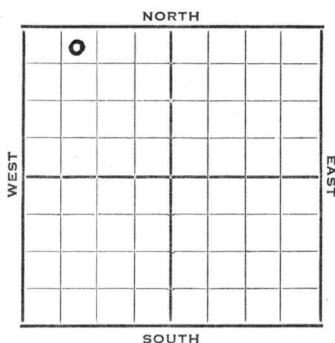

1952 Elev. 1628' REPORT

4/16 8" @ 190'
Drlg. 2500'

4/21 Miss 3413 SO 3415-17 RTD
5" @ 3416 WOCT

4/30 Spud 4-10-52
Oil Well TD 3428
8" @ 190
Cong. 3406 Miss. 3413
SO 3416-17
5" @ 3416 TD 3417 DD 3428
S/ 7 boph 6 hr. S/ 8 boph
16 hr. Comp. 50 bopd

COMPLETED

County **Rice** State **Kansas**
 Sec. **4** (Blk.) **21** (Sur.) **6W** Map No.
 Operator **Seegar & Sterling**
 Well No. **5** Farm **Clevinger**
 Elev. Location **NE NW NW**

0					

FIRST REPORT

330 Ft. From **N** Line **NW**
990 Ft. From **W** Line Quarter
 Ist. Report **APR 16 1952**

Completion

Remarks

Spudding Date

Drlg. Data

8" @ 190 Drlg. 2500

J. G. McGEHEE

County Rice State Kansas
 Sec. 4 (Blk. 21 (Sur. 6W Map No.
 (Twp.) (Rge.)
 Operator Seegar & Sterling
 Well No. 5 Farm Clevinger
 Elev. 1628 Location NE NW NW

0					

330 Ft. From N Line NW

990 Ft. From W Line Quarter

1st. Report

Completion APR 30 1952

Remarks

Spudding Date 4-10-52

Drlg. Data Oil well TD 3428

8" @ 190 Cong. 3406 Miss. 3413

SO 3416-17 5" @ 3416 TD 3417

DD 3428 S/ 7 boph 6 hr. S/ 8 boph
16 hr. Comp. 50 bopd

J. G. McGEHEE