


Section 27 Township 20 Range 11W

Well No. 1 Russell

Company D.R. Lauck

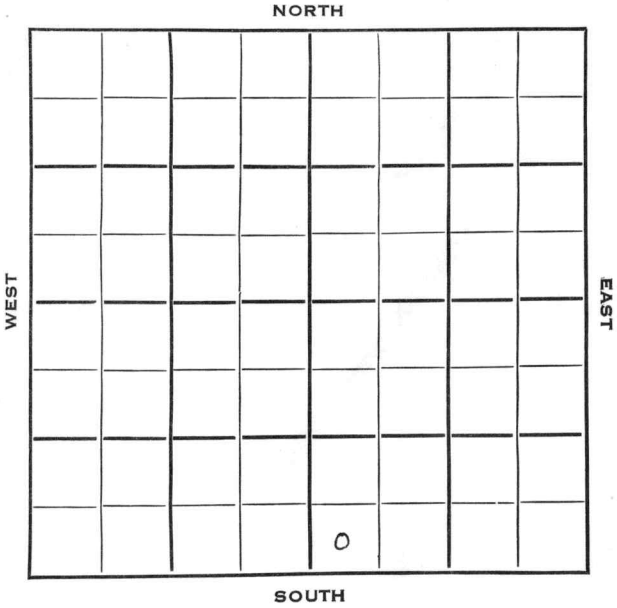

Barton

KANSAS



Sec. 27 Twp. 20 R. 14 W

Well No. # 1 Russell Farm

D. R. Lauck Company

Lauck Contractor


Ft. from N. Line

330 Ft. from S. Line

Ft. from E. Line

330 Ft. from W. Line

SW SW SE
Sunray - DHM

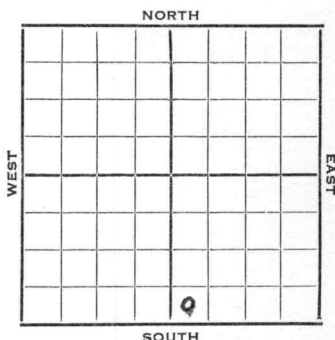

1953 Elev. 1903' REPORT

4/8 Spud 4-2-53
8" @ 576 Anhy 830'
Drlg. 2080'

4/16 Heeb 3194, Br. L. 3298, Lans 3308
DST 3302-19 $\frac{1}{2}$ hr. 1100' wtr 1240#
Cong 3553, Arb 3581
DST

4/22 Spud 4-2-53
D&A
TD 3622
8" @ 576
Anhy 830, Heeb 3194, Br line 3298,
Lans 3308
DST 3302-19, opn $\frac{1}{2}$ hrs., rec. 1100'
wtr., 1240#
Cong 3553, Arb 3581
DST 3585-3622, opn $\frac{1}{2}$ hrs., rec. 215'
wtr., 1120#
TD 3622
D&A

ABANDONED

County

State

Kansas

Sec.

27

(Blk.)
(Twp.)

20

(Sur.)
(Rge.)

14W

Map No.

Operator

D. R. Lauck

Well No.

1

Farm

Russell

Elev.

Location

SW SW SE

FIRST REPORT

330 Ft. From

S

Line

SE

330 Ft. From

W

Line

Quarter

1st. Report

APR

8

1953

Completion

Remarks

Sunray - DHM

Lauck - Contr.

Spudding Date


4-2-53

Drlg. Data

8th @ 576

Anhy 830

drlg. 2080

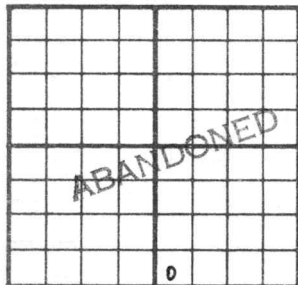County Barton State KansasSec. 27 (Blk.) 20 (Sur.) 14W Map No.Operator D. R. LauckWell No. 1 Farm RussellElev. 1903 Location SW SW SE330 Ft. From S Line SE330 Ft. From W Line Quarter

1st. Report

Completion APR 22 1953

Remarks

Lauck - Contr.Spudding Date 4-2-53Drlg. Data D & A TD 36228" @ 576 Anhy 830 Heeb. 3194Br. lime 3298 Lans. 3308 DST 3302-19open $\frac{1}{2}$ hr. Rec. 1100' wtr. 1240#Cong. 3553 Arb. 3581 DST 3585-3622open $\frac{1}{2}$ hr. Rec. 215' wtr. 1120#TD 3622