


Section 4 Township 21 Range 6N

Well No. 1 Johnson

Company Sterling et al

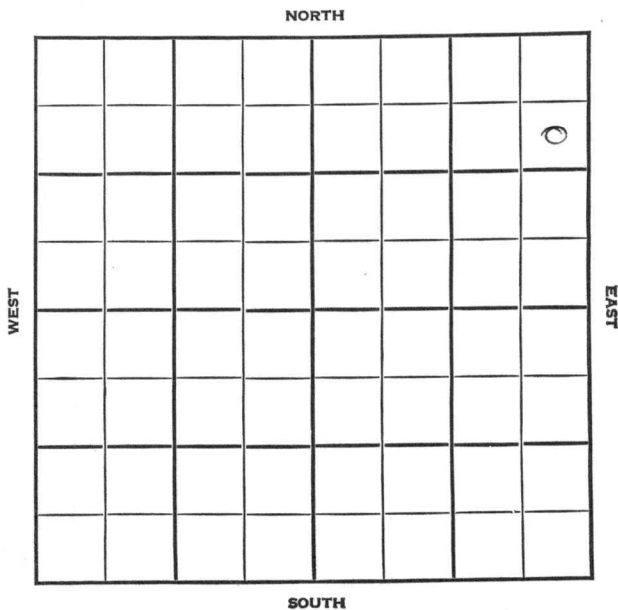

Sec. 4 Twp. 21 R. 6W

Well No. #1 Johnson Farm
Sterling et al Company
Welch


990 Ft. from N. Line

_____ Ft. from S. Line

330 Ft. from E. Line

_____ Ft. from W. Line

SE NE NE

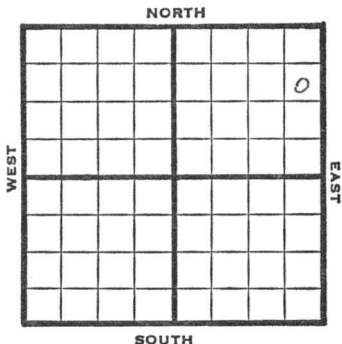

1948

Elev. -

R E P O R T

4/28

8" @ 134'
Drlg. 2488'

5/5

"

5/12

Miss. 3392'
5" @ 3394'
TD 3426'
1000' oil.

5/19

"

6/1

Miss 3392'
5" @ 3394'
Pump 48 oil Pot.
Gr. 39°
TD 3426'

COMPLETED

Map No. _____ Sec. 4 Twp. 21 R. 6W

Well No. 1 Johnson

Sterling etal. Company

FIRST REPORT Contractor

SE NE NE

SECTION PLAT

990 Ft. from N. Line

_____ Ft. from S. Line

330 Ft. from E. Line

_____ Ft. from W. Line

			o

Rice County

Location _____

Rig up _____

Drilling and Remarks:

8" @ 134

drlg. 2488

RECORD

Cased _____ in., _____ ft.

Sand _____

Gas _____

Oil _____

Total Depth _____

PRODUCTION

1st 24 hrs. Nat. _____

1st 24 hrs. after shot _____

Gas _____ Cu. Ft.

Dry Hole _____

Abandoned _____

Date

APR 28 1948 19

S. J. LEWIS Scout

Map No. 48 Sec. 4 Twp. 21 R. 6W

Well No. 1 Johnson

Sterling et al. Company

COMPLETE Contractor

SE NE NE

SECTION PLAT

990 Ft. from N. Line

_____ Ft. from S. Line

330 Ft. from E. Line

_____ Ft. from W. Line

			o

Rice County

RECORD

Location _____

Cased _____ in., _____ ft.

Rig up _____

Sand _____

Drilling and Remarks:

Gas _____

This 3392

Oil

5" @ 3394

Total Depth 3426


PRODUCTION

1st 24 hrs. Nat. _____

1st 24 hrs. after shot _____

Gas _____ Cu. Ft.

Dry Hole _____

Abandoned _____

Date

JUN 1 1948

19

S. J. LEWIS

Scout