

Map No. _____ Sec. 4 Twp. 23 R. 9

Well No. 1 Henry Farm


Great Southern Company

1320 Ft. from N. Line

_____ Ft. from S. Line

200 Ft. from E. Line

_____ Ft. from W. Line

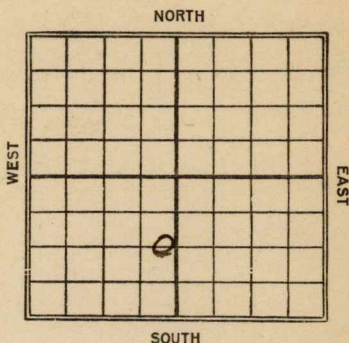

Date _____

REPORT

Date 1923

4/20	Reg.
------	------

6/10	D.4 a - 2328'
------	---------------

Map No. **KANSAS** ¹⁵ Sec. **4** Twp. **25** R. **9**

Well No. **1 Henry**
Great Southern Company

Contractor

FIRST REPORT

SECTION PLAT

1320 Ft. from N. Line
Ft. from S. Line
200 Ft. from E. Line
Ft. from W. Line

Location

Rig up **V V**

Drilling and Remarks:

RECORD

Cased _____ in., _____ ft.
Sand _____
Gas _____
Oil _____
Total Depth _____

PRODUCTION

1st 24 hrs. Nat. _____
1st 24 hrs. after shot _____
Gas _____ Cu. Ft.
Dry Hole _____
Abandoned _____

Date

APR 20 1923

191 _____ Scout

Map No. KANSAS 15 Sec. 4 Twp. 25 R. 9

Well No. 1 Henley

G. L. Southern Company

Contractor

ABANDONED SECTION PLAT

1320 Ft. from N. Line

_____ Ft. from S. Line

200 Ft. from E. Line

_____ Ft. from W. Line

Location _____

Rig up _____

Drilling and Remarks:

2049
2327'

RECORD

Cased _____ in., _____ ft.

Sand _____

Gas _____

Oil _____

Total Depth _____

PRODUCTION

1st 24 hrs. Nat. _____

1st 24 hrs. after shot _____

Gas _____ Cu. Ft.

Dry Hole _____

Abandoned _____

Date _____

M. A. BENEAR

JUN 10 1923

Scout