


Section 4 Township 21 Range 6-W

Well No. #2 Johnson

Company Sterling Drlg.

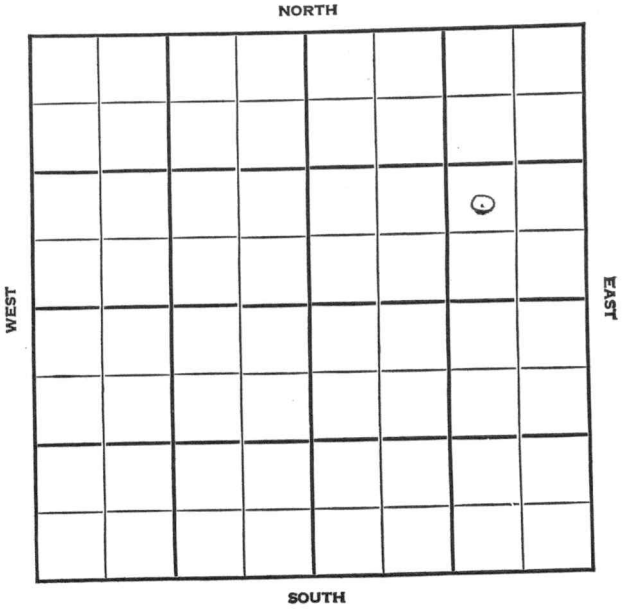

KANSAS

Rice

Sec. 4 Twp. 21 R. 6W

Well No. #2 Johnson Farm

Sterling Drlg.

Company

Welch Pool


 Ft. from N. Line

990' Ft. from S. Line

990' Ft. from E. Line

 Ft. from W. Line

NW SE NE

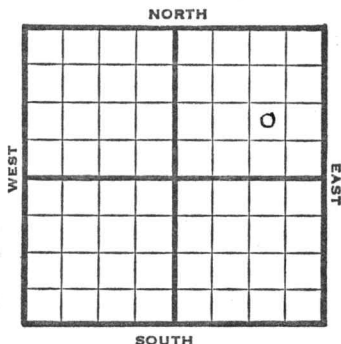

1948

Eli 1604'

REPORT

7/21

RUR

8/28

8" @ 100'

Drlg 200'

8/4

Drlg. 3080'

8/11

Mississippi 3400'-17'

TD 3417'

5" @ 3409'

8/18

Mississippi 3400'

5" @ 3409'

TD 3434'

Pump 50 oil Pot

38° Gr.

Comp

COMPLETED

Map No. _____ Sec. 4 Twp. 21 R. 6W

Well No. 2 Johnson

Sterling Drlg. Company

FIRST REPORT Contractor

NW SE NE

SECTION PLAT

_____ Ft. from N. Line

990 Ft. from S. Line

990 Ft. from E. Line

_____ Ft. from W. Line

			o

Rice County

Location _____

Rig up _____

Drilling and Remarks:

RUR

RECORD

Cased _____ in., _____ ft.

Sand _____

Gas _____

Oil _____

Total Depth _____

PRODUCTION

1st 24 hrs. Nat. _____

1st 24 hrs. after shot _____

Gas _____ Cu. Ft.

Dry Hole _____

Abandoned _____

Date

JUL 21 1948 19 _____ S. J. LEWIS Scout

Rice County Kansas State

Map No. 48 Sec. 4 Twp. 21 R. 6W

Well No. 2 Johnson

Sterling Drlg. Company

COMPLETE Contractor

NW SE NE

E 11604
SECTION PLAT

 Ft. from N. Line

990 Ft. from S. Line

990 Ft. from E. Line

 Ft. from W. Line

Welch Pool

Remarks:

Miss 3400

5" C 3409

Y 12 3434

Pump 50 oil Rod

38-4

Date

AUG 18 1948

Scout

S. J. LEWIS