


Butler Co
Map No. Kansas Sec. 13 Twp. 25 R. 3^E
Well No. 1 E. C. Wilson Farm
Kelly Oil Company

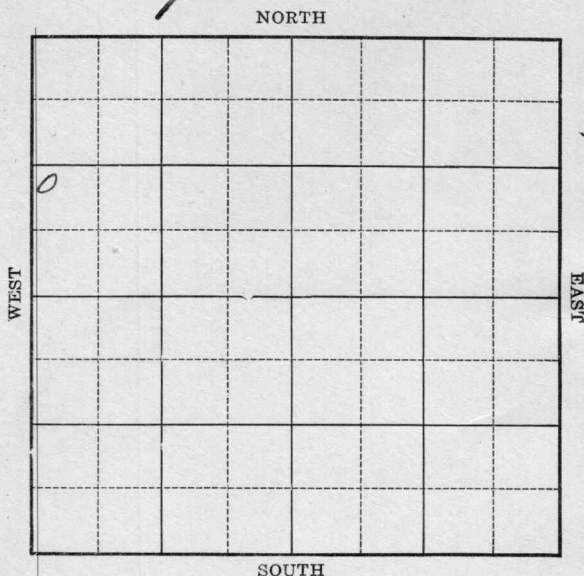

Location _____

Drilling Remarks _____

Rig Up _____

Drilling Remarks _____

RECORD

Cased _____ in. _____ ft.

Sand _____

Gas _____

Oil _____

Total Depth _____

PRODUCTION

1st 24 hrs. Nat. _____

1st 24 hrs. after shot _____

Gas _____ cu. ft.


Dry Hole _____

Abandoned _____

Map No. **KANSAS** Sec. **13** Twp. **25** R. **2**
 Well No. **1 E. C. Wilson** Farm
Sully Oil Company

Ft. from N. Line
990 Ft. from S. Line
 Ft. from E. Line
330 Ft. from W. Line

1925
10/28

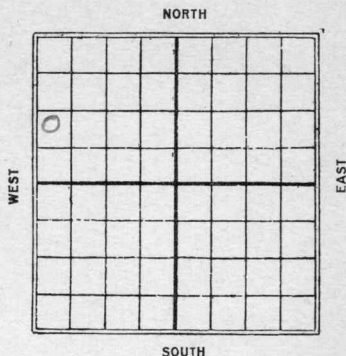

Date REPORT

10/28 R.O.G

10/22

10/21 ~~swatting 35 ft~~

10/14 Rig

11/11 Rigin up

11/18 Riggd up & S.D.

1926

2/9 Abandoned 3125

K13

Map No. KANSAS Sec. 13 Twp. 26 R. 3 E

Well No. 1 E C Wilson

Shelly Oil Company

Contractor

SECTION PLAT

_____ Ft. from N. Line

990 Ft. from S. Line

_____ Ft. from E. Line

330 Ft. from W. Line

0			

FIRST REPORTS

Location _____

Rig up _____

Drilling and Remarks:

ROG

RECORD

Cased _____ in., _____ ft.

Sand _____

Gas _____

Oil _____

Total Depth _____

PRODUCTION

1st 24 hrs. Nat. _____

1st 24 hrs. after shot _____

Gas _____ Cu. Ft.

Dry Hole _____

Abandoned _____

Date

OCT 28 1925

S. J. LEWIS

Scout

Previous reports
show #1 a producing
well in NW cor.
of this $\frac{1}{4}$ section.

Is this the correct
number for this
location.

Lewis note how I changed
location of this well if
O.K. say OK and sign
below! Thanks Sam

O.K. herein
ME SW NW

Returned	gm
Cards	2082
Tracing	P
France Map	
Scarborough Map	
Moody Map	
Scarborough Plat Book	
Moody Plat Book	

Sam;

Well No 1 in the N.W. NW.

is producing

Well No 1 in the NW. SW. NW.

is a rig.

This party Nelson gave
the 8 1/2 of this quarter to
his wife, to beat the income
tax.

So there will be two
different leases.

Lewis

Returned	
Cards	AP
Tracing	
France Map	P
Scarborough Map	AP
Moody Map	
Scarborough Plat Book	
Moody Plat Book	

Butler
 K13 KANSAS SEC. 13 TWP. 25S R. 3E

WELL NO. *E. C. Wilson*

Skelly Oil

COMPANY

CONTRACTOR

SECTION PLAT

ABANDONED

0			

_____ FT. FROM N. LINE

_____ FT. FROM S. LINE

_____ FT. FROM E. LINE

_____ FT. FROM W. LINE

LOCATION _____

RIG UP _____

DRILLING AND REMARKS:

T.L. 3005
3125 H.E.V.

OK

RECORD

CASED _____ IN. _____ FT.

SAND _____

GAS _____

OIL _____

TOTAL DEPTH *3129*

PRODUCTION

1ST 24 HRS. NAT. _____

1ST 24 HRS. AFTER SHOT _____

GAS _____ CU. FT.

DRY HOLE *✓*

ABANDONED *✓*

DATE

3/3 192 *6*

SCOUT

Map No. KANSAS Sec. 13 Twp. 25 R. 3E

Well No. 1 E. C. Nelson

Spelly Oil Company

Contractor

SECTION PLAT

_____ Ft. from N. Line

990 Ft. from S. Line

_____ Ft. from E. Line

330 Ft. from W. Line

ABANDONED

0			

Location _____

Rig up _____

Drilling and Remarks:

TD 3125

D & A.

RECORD

Cased _____ in., _____ ft.

Sand _____

Gas _____

Oil _____

Total Depth _____

PRODUCTION

1st 24 hrs. Nat. _____

1st 24 hrs. after shot _____

Gas _____ Cu. Ft.

Dry Hole _____

Abandoned _____

Date

MAR 9 1926

S. J. LEWIS

Scout