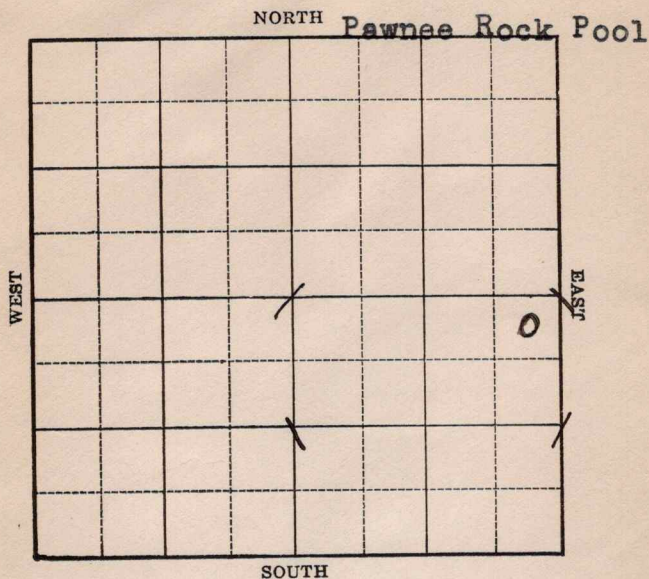


Section 14 Township 20 Range 16-WWell No. 1 NelsonCompany Texon

KANSAS

Pawnee

Sec. 14 Twp. 20 R. 16-WWell No. #1 Nelson Farm _____

Texon

Company _____

(Pawnee Rock)


330 Ft. from N. Line

Ft. from S. Line _____

330 Ft. from E. Line

Ft. from W. Line _____

Elev. 2058

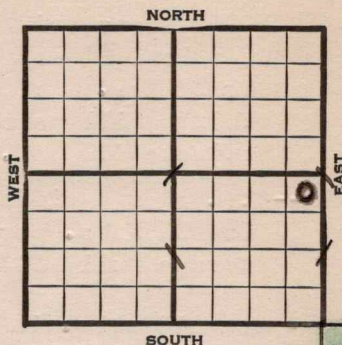

1939	REPORT
5/10	Location
5/19	Rigging up rotary.
5/26	20' of 15". 700' of 10-3/4"
	Anhy 1055' Drlg. 2078'
5/29	Dlg. 3233 (Tel)
6/1	Lans. ³⁴⁸⁹ 3476 ' Drlg. 3539'
6/5	Top Arbuckle 3774 Core 3774-84
	Rec. 8 feet dry
	Core 3784-90 Recovered 3 feet
	18" slight saturation 18" dry
	Reaming to core ahead (Tel)
6/6	Drilled to T.D. 3801 Small show oil
	& gas all way to bottom Will check
	core to see if run pipe (Tel)
6/8	Lansing 3489 (Corrected) Simpson 3765
	Arb. ³⁷⁷⁸ 3774 6" ³⁸⁰¹ 3798 TD ³⁸⁰⁴ 3801 SO Rust
6/13	Correction--T.D. 3804 6" 3801
	Drilled cement Filled up 1100 feet oil
	in 7 hrs. Est. 1/4 M Gas
	Will acidize (Tel)
	OVER
	OVER

752648

1939

6/16--Arbuckle 3778 (Dtg. report) 3774 T.D. 3806

500 gallons acid thru casing

Swab load Swab & flow 10 bbls. per hour
for 24 hrs. Acidized 1000 gallons thru
tubing Will test

Estimate 500 bbl. well (Tel)

6/19--T.D. 3806 Acidized 1000 gallons

Flow 30 bbls. per hour for 3 hours

Storage full Bldg. tanks (Tel)

6/23--Flow 118 bbls. in 8 hrs. thru 3" tubing
Potential 354 bbls. (Tel)

6/28 Arb. 3778'

6" - 3801'

T.D. 3806'

1500 acid.

Flow 118.08 bbls. 8 hours.

Potential 354 bbls.

COMPLETED

Pawnee

KANSAS

Map No. 81 Sec. 14 Twp. 20 R. 16WWell No. 1 NelsonTexon

Company

Contractor

FIRST REPORT

NE SE

330 Ft. from N. Line Ft. from S. Line330 Ft. from E. Line Ft. from W. Line

SECTION PLAT

PAWNEE ROCK POOL

Location XRig up

Drilling and Remarks:

(Special)

 $\frac{1}{2}$ Mi. North of

Mid-Cont. Bixby

RECORD

Cased in., ft.Sand Gas Oil Total Depth

PRODUCTION

1st 24 hrs. Nat. 1st 24 hrs. after shot Gas Cu. Ft.Dry Hole Abandoned

Date

MAY 10 1939

19

S. J. LEWIS

Scout

Pawnee

KANSAS

Map No. 81 Sec. 14 Twp. 20 R. 16WWell No. 1 Nelson

Texon

Company

Contractor

COMPLETED

SECTION PLAT

NE SE

330 Ft. from N. Line Ft. from S. Line330 Ft. from E. Line Ft. from W. Line

			6

PAWNEE ROCK POOL

Location Rig up

Drilling and Remarks:

*Art. 3778**6" @ 3801**1500 acid**Flow 118.08-8 hrs**P 354*

RECORD

Cased in., ft.Sand Gas Oil Total Depth 3806

PRODUCTION

1st 24 hrs. Nat. 1st 24 hrs. after shot Gas Cu. Ft.Dry Hole Abandoned

Date

JUN 28 1939

19

S. J. LEWIS

Scout