


Section 14 Township 25 Range 3EWell No. 1 FreemanCompany R Wixson et al

Misc.

NORTH

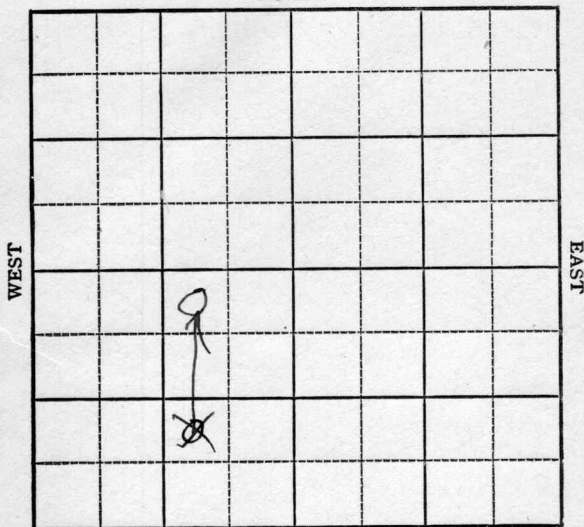

SOUTH

Sec. 14 Twp. 25 R. 3E

Well No. 1 Freeman Farm

R. Wixson et al Company


Misc.

330' Ft. from N. Line

990 Ft. from S. Line

990 Ft. from E. Line

Ft. from W. Line

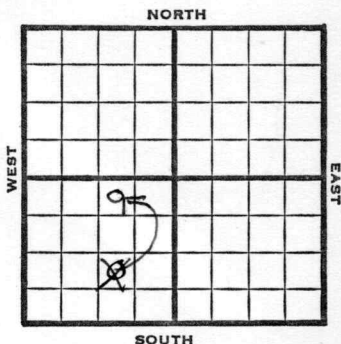

NW SE SW
NW NE SW

1948 Elev. 1346' REPORT

9/1 Machine

9/8 Drlg. 510'

9/14 Drlg. 1510'

9/21 10" @ 1325'
Drlg. 1905'

9/29 KC 2010'
8" @ 2300'
Mississippi 2600'
Drlg. 2635'

10/6 Viola 2746'
TD 2786'

ABANDONED

Butler County Kansas State

Map No. _____ Sec. 14 Twp. 25 R. 3E

Well No. 1 Freeman

R. Wixson et al. Company

FIRST REPORT Contractor

NW SE SW


SECTION PLAT

_____ Ft. from N. Line

990 Ft. from S. Line

990 Ft. from E. Line

_____ Ft. from W. Line

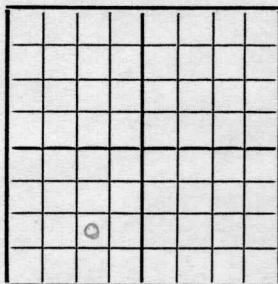

Miscellaneous

Remarks:

Machine

Date
SEP 1 1948

Scout **S. J. LEWIS**

Butler County Kansas State

Map No. 13 Sec. 14 Twp. 25 R. 3E

Well No. 1 Freeman

R. Wixson et al. Company

CORRECTION

Contractor

NW NE SW

SECTION PLAT

330 Ft. from N. Line

 Ft. from S. Line

990 Ft. from E. Line

 Ft. from W. Line

Miscellaneous

Remarks:

Reported NW SE SW

Date

SEP 8 1948

Scout **S. J. LEWIS**

Map No. 13 Sec. 14 Twp. 25 R. 3E

Well No. 1 Freeman

R. Wixson et al. Company

ABANDONED Contractor

NW NE SW

E 1, 1346
SECTION PLAT

330 Ft. from N. Line

 Ft. from S. Line

990 Ft. from E. Line

 Ft. from W. Line

	d		

Butler County

Location

Rig up

Drilling and Remarks:

No. 2746

RECORD

Cased in., ft.

Sand

Gas

Oil

Total Depth 2786

PRODUCTION

1st 24 hrs. Nat.

1st 24 hrs. after shot

Gas Cu. Ft.

Dry Hole

Abandoned

Date

OCT 6 1948 19 S. J. LEWIS Scout