

Map No. KANSAS Sec. 3 Twp. 21 R. 6^w

Well No. 1- Rayney Farm
Hipple & Leggett Company
NORTH


330 Ft. from N. Line

_____ Ft. from S. Line

1023 Ft. from E. Line

_____ Ft. from W. Line

1932

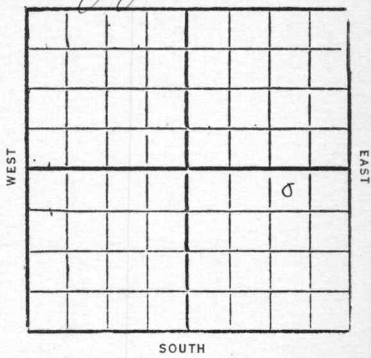

Date	REPORT
6/29	CoS.
7/6	
7/13	Reg
7/20	Run up
7/27	Spdg
8/3	
8/10	20"-80
	15"-138
	Dreg 875
8/17	12"-874
	dreg 1690'
8/24	10"-1855
	Dreg 1925'
8/31	10"-1902
	dreg 2485'
9/7	UR 8"-2765
9/14	8"-2762
	Dreg 2935
9/21	6"-3120
	Plg out
9/30	Dreg 3225'
	(over)

10/5- Top Chat 3360
5"- 3360
Pay 3382-91
TD 3393
3000' oil in hole
Prep to pump.

10/12- TD 3393 No test

10/19- Chat 3360
Pay 3382-91
TD 3393
Est 125 bbl oil
Comp

Rice

Map No. 48 KANSAS Sec. 3 Twp. 21 R. 6 ^W

Well No. 1 Rainey

Hipple & Liggett Company

Contractor

FIRST REPORTS

330 Ft. from N. Line

..... Ft. from S. Line

1023 Ft. from E. Line

..... Ft. from W. Line

SECTION PLAT

			o

Location.....

Rig up.....

Drilling and Remarks:

Pro y

RECORD

Cased..... in., ft.

Sand.....

Gas.....

Oil.....

Total Depth.....

PRODUCTION

1st 24 hrs. Nat.....

1st 24 hrs. after shot.....

Gas..... Cu. Ft.

Dry Hole.....

Abandoned.....

Date

JUN 29 1932

CHAS. L. SHERWOOD

192.....

Scout

Rice

48 **KANSAS** Sec. 3 Twp. 21 R. 6W

Well No. 1 *Rainey*

Hipple + Liggett Company

COMPLETED

Contractor

OCT 19 1932

SECTION PLAT

330 Ft. from N. Line

..... Ft. from S. Line

1023 Ft. from E. Line

..... Ft. from W. Line

			●

Location.....

Rig up.....

Drilling and Remarks:

chat 3360
pay 3382-91
Est. 125 BBLs

RECORD

Cased.....in.,ft.

Sand.....

Gas....."

Oil.....

Total Depth 3393

PRODUCTION

1st 24 hrs. Nat.....

1st 24 hrs. after shot.....

Gas.....Cu. Ft.

Dry Hole.....

Abandoned.....

Date

Oct 19 1932

Sherwood Scout