

# KANSAS


FORM 51 5M 4-41 PETROL

Butler

Section 12 Township 25 Range 3E

Well No. 3-Don Wilson

Company Wilson Oil

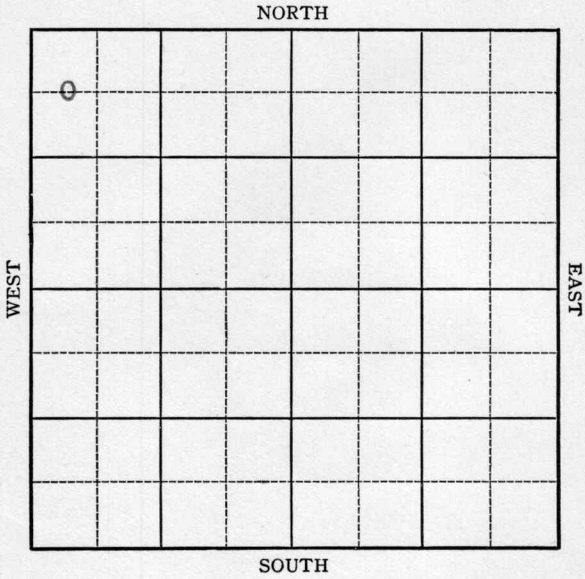

Sec. 12 Twp. 25 R. 3-E

Well No. #3 Don Wilson Farm

Wilson Oil Company


(Misc.)

660 Ft. from N. Line

\_\_\_\_\_ Ft. from S. Line

\_\_\_\_\_ Ft. from E. Line

330 Ft. from W. Line

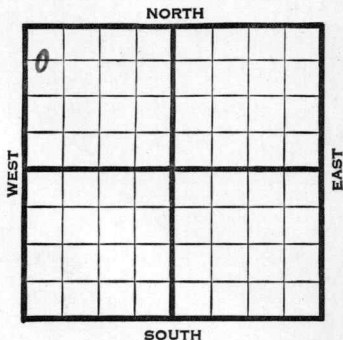

Elev. 1298

1941	REPORT
9/3	Location
9/11	"
9/18	Machine.
9/25	12" - 50' Drlg. 960'
10/2	10" - 1312' Drlg. 1575'
10/9	Drlg. 2200'
10/16	K.C. 2215' 8" - 2300'
	Drlg. 2331'
10/23	Drlg. 2555'
10/30	Miss. 2663' 6" - 2663'
	T.D. 2678' 400' oil.
11/6	" " " "
11/13	Shut down.
11/19	Miss. 2663'
	6" - 2663'
	T.D. 2678'
	2000 acid.
	Potential 150 bbls., pump.
	34.5 Gravity

COMPLETED

Map No. 13 Sec. 12 Twp. 25 R. 3E

Well No. 3 Don Wilson

Wilson Oil Company

FIRST REPORT Contractor

SECTION PLAT

C W L NW NW

660 Ft. from N. Line

\_\_\_\_\_ Ft. from S. Line

\_\_\_\_\_ Ft. from E. Line

330 Ft. from W. Line

0			

MISCELLANEOUS

Location X

Rig up \_\_\_\_\_

Drilling and Remarks:

RECORD

Cased \_\_\_\_\_ in., \_\_\_\_\_ ft.

Sand \_\_\_\_\_

Gas \_\_\_\_\_

Oil \_\_\_\_\_

Total Depth \_\_\_\_\_

PRODUCTION

1st 24 hrs. Nat. \_\_\_\_\_

1st 24 hrs. after shot \_\_\_\_\_

Gas \_\_\_\_\_ Cu. Ft.

Dry Hole \_\_\_\_\_

Abandoned \_\_\_\_\_

Date

SEP 3 1941 19

S. J. LEWIS Scout

Map No. K-13 Sec. 12 Twp. 25 R. 3E

Well No. 3 Don Wilson

Wilson Oil Company

**COMPLETED** Contractor

C WL NW NW

SECTION PLAT

660 Ft. from N. Line

\_\_\_\_\_ Ft. from S. Line

\_\_\_\_\_ Ft. from E. Line

330 Ft. from W. Line

6			

MISCELLANEOUS

RECORD

Location \_\_\_\_\_

Cased \_\_\_\_\_ in., \_\_\_\_\_ ft.

Rig up \_\_\_\_\_

Sand \_\_\_\_\_

Drilling and Remarks:

Gas \_\_\_\_\_

Oil \_\_\_\_\_

Total Depth 2678

*Mis 2663  
6" @ 2663  
2000 acid  
Pump 15' @ 2663*

PRODUCTION

1st 24 hrs. Nat. \_\_\_\_\_

1st 24 hrs. after shot \_\_\_\_\_

Gas \_\_\_\_\_ Cu. Ft.

Dry Hole \_\_\_\_\_

Abandoned \_\_\_\_\_

*345 yr*

Date

NOV 19 1941

S. J. LEWIS Scout