


Kansas

Map No. _____ Sec. 4 Twp. 25 R. 9Well No. 1 Henry Farm _____Rogers & Butler Company _____

NORTH

WEST

EAST

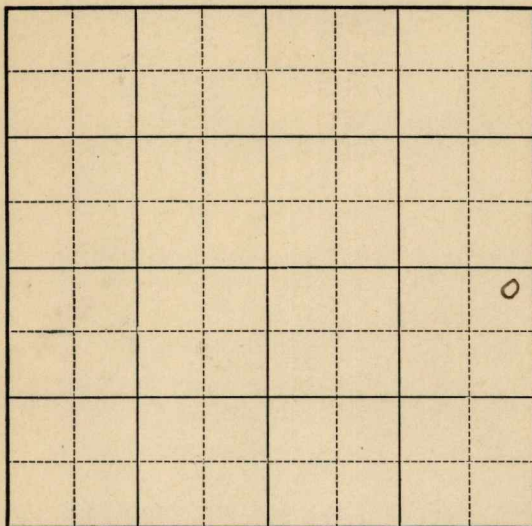

SOUTH

FIRST REPORT

Location _____

Drilling Remarks:

Rig Up _____

Drilling Remarks:

RECORD

Cased _____ in. _____ ft.

Sand _____

Gas _____

Oil _____

Total Depth _____

PRODUCTION

1st 24 hrs. Nat. _____

1st 24 hrs. after shot _____

Gas _____ cu. ft.

Dry Hole _____


Abandoned _____

Map No. K. Sec. 4 Twp. 25 R. 9Well No. 1 Henley. Farm
Rogers & Bettler Company200 Ft. from N. Line

Ft. from S. Line

200 Ft. from E. Line

Ft. from W. Line

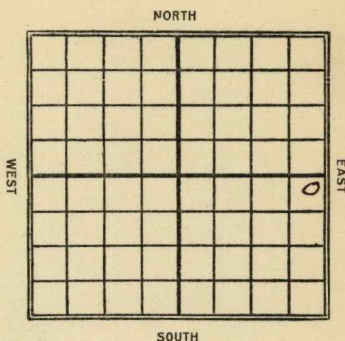

Date

REPORT

192211/24 Dlg. 300'19231/6 Sand 2260-2325- P.B. 2315
Shot 120 qts. 125 Bbls.

Map No. **KANSAS** ^N Sec. ⁴ Twp. ²⁵ R. ⁹Well No. *Henry**Rogers & Pettles* Company

Contractor

FIRST REPORT

SECTION PLAT

200 Ft. from N. Line

Ft. from S. Line

200 Ft. from E. Line

Ft. from W. Line

			o

Location

Rig up

Drilling and Remarks:

10 300

RECORD

Cased _____ in., _____ ft.

Sand _____

Gas _____

Oil _____

Total Depth _____

PRODUCTION

1st 24 hrs. Nat. _____

1st 24 hrs. after shot _____

Gas _____ Cu. Ft.

Dry Hole _____

Abandoned _____

Date

NOV 24 1922 191

M. A. BENEAR Scout

Map No. **KANSAS** 15 Sec. **4** Twp. **25** R. **9**

Well No. **1** *Wenley*

Rogers & Bittler Company

Contractor

COMPLETED

SECTION PLAT

200 Ft. from N. Line

_____ Ft. from S. Line

200 Ft. from E. Line

_____ Ft. from W. Line

Location _____

Rig up _____

Drilling and Remarks:

Pay 2260-2325

T.D. 2237

Plug back 2315

shot 120 gals.

RECORD

Cased _____ in., _____ ft.

Sand _____

Gas _____

Oil _____

Total Depth _____

PRODUCTION

1st 24 hrs. Nat. _____

1st 24 hrs. after shot **125**

Gas _____ Cu. Ft.

Dry Hole _____

Abandoned _____

Date

JAN 6 1923

M. A. BENEAR

191

Scout