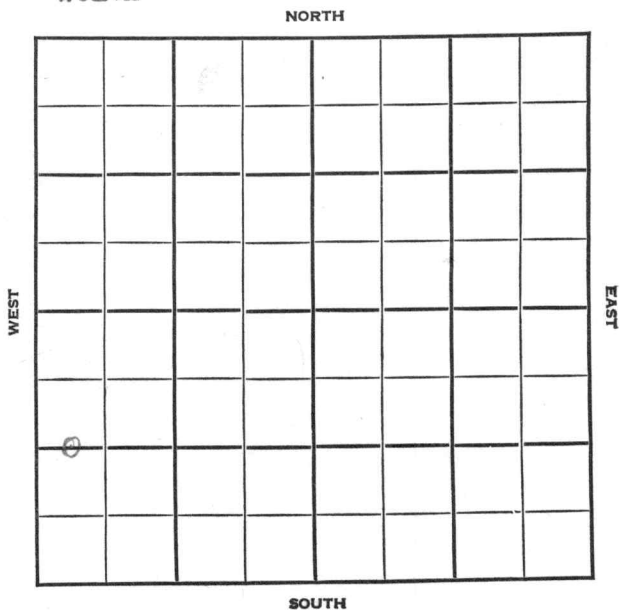


KANSAS Rice

Section 4 Township 21 Range 6WWell No. #5 FeeCompany Branine & Holl
Welch

KANSAS

Rice

Sec. 4 Twp. 21 R. 6W

Well No. #5 Fee Farm

Branine & Holl Company

Welch Pool


1320' Ft. from N. Line

Ft. from S. Line

Ft. from E. Line

300' Ft. from W. Line

C W L SW

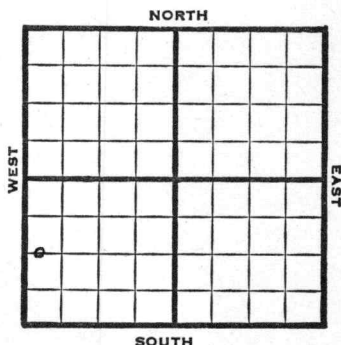

1948

Elev. 1645' REPORT

1/7 Drlg. 2450'

1/14 8" @ 300'
Drlg 2390'

1/21 Mississippi 3431'
5" @ 3431'
TD 3451'
2800' oil 2½ hrs.

1/26 "

2/4 Miss. 3431'
5" @ 3431'
Pump 50 Pot
Gr. 36.0
TD 3451'
Comp.

COMPLETED

Map No. _____ Sec. 4 Twp. 21 R. 6W

Well No. 5 Fee

Branine & Holl

Company

FIRST REPORT

Contractor

C W L SW


SECTION PLAT

1320 Ft. from N. Line

_____ Ft. from S. Line

_____ Ft. from E. Line

330 Ft. from W. Line

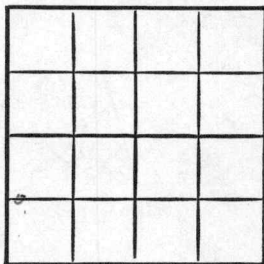

Rice County

Location _____

Rig up _____

Drilling and Remarks:

drlg. 2450

RECORD

Cased _____ in., _____ ft.

Sand _____

Gas _____

Oil _____

Total Depth _____

PRODUCTION

1st 24 hrs. Nat. _____

1st 24 hrs. after shot _____

Gas _____ Cu. Ft.

Dry Hole _____

Abandoned _____

Date

JAN 7 1948 19

S. J. LEWIS

Scout

Map No. 48 Sec. 4 Twp. 21 R. 6 W

Well No. 5 Fee

Branine & Holl

Company

COMPLETE

Contractor

C W L SW


E1, 1645
SECTION PLAT

1320 Ft. from N. Line

_____ Ft. from S. Line

_____ Ft. from E. Line

330 Ft. from W. Line

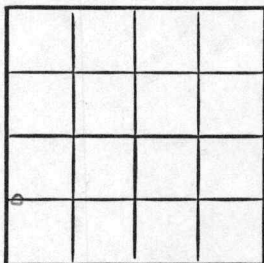

Rice County

Location _____

Rig up _____

Drilling and Remarks:

Miss 3481

5' C 3481

Pump 50 BX

86 9/16

RECORD

Cased _____ in., _____ ft.

Sand _____

Gas _____

Oil ☒ _____

Total Depth 3457

PRODUCTION

1st 24 hrs. Nat. _____

1st 24 hrs. after shot _____

Gas _____ Cu. Ft.

Dry Hole _____

Abandoned _____

Date

FEB 4 1948

19

S. J. LEWIS

Scout