

KANSAS

Map No. 13 Sec. 23 Twp. 23 R. 3

Well No. 1 Wilson Farm

Spelley Oil Company

NORTH

0

WEST

EAST

SOUTH

Location _____

Drilling Remarks

Rig Up_____

Drilling Remarks

RECORD

Cased _____ in. _____ ft.

Sand

Gas

Oil

Total Depth.....

PRODUCTION

1st 24 hrs. Nat. _____

1st. 24 hrs. after shot.....

Gas _____ cu. ft.

Dry Hole

Abandoned


Map No. *Kana* Sec. *13* Twp. *25* R. *3*
 Well No. *1 Wilson* Farm
skelly oil Company

200 Ft. from N. Line

_____ Ft. from S. Line

_____ Ft. from E. Line

200 Ft. from W. Line

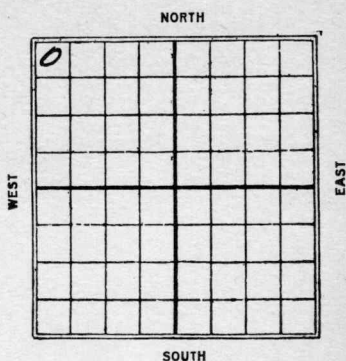

1925

Date REPORT

8/14 R.O. G.

8/20 Rig & Tools.

8/27

9/12 spud.

9/9 spud + S.D.

9/16

9/24 Log @ 1400'

9/30 ✓ ✓ 2200

10/6 ✓ ✓ 2500

10/22 Top sand 2662

Bottom sand 2668 T.D.

35 bbls mat

60/35 bbls

Ticket Returned

Map No. Butter Sec. 13 Twp. 25 R. 34

Well No. 1 Wilson

Spek Oil Co. Company

Contractor

FIRST REPORT

200 Ft. from N. Line

_____ Ft. from S. Line

_____ Ft. from E. Line

200 Ft. from W. Line

SECTION PLAT

0			

Location _____

Rig up _____

Drilling and Remarks:

R.O.G.

RECORD

Cased _____ in., _____ ft.

Sand _____

Gas _____

Oil _____

Total Depth _____

PRODUCTION

1st 24 hrs. Nat. _____

1st 24 hrs. after shot _____

Gas _____ Cu. Ft.

Dry Hole _____

Abandoned _____

Date

AUG 12 1925

192

S. J. LEWIS

Scout

Map No. **KANSAS** Sec. 13 Twp. 25 R. 3E

Well No. 1 Wilson

Spelley Oil Company

Contractor

SECTION PLAT

330 Ft. from N. Line

_____ Ft. from S. Line

_____ Ft. from E. Line

330 Ft. from W. Line

0			

COMPLETED

Location _____

Rig up _____

Drilling and Remarks:

TS 2662
 BS 2668
 TD 2688-3088 1/2
 Shot 609 to. No. 8
 3088 1/2

RECORD

Cased _____ in., _____ ft.

Sand _____

Gas _____

Oil _____

Total Depth _____

PRODUCTION

1st 24 hrs. Nat. _____

1st 24 hrs. after shot _____

Gas _____ Cu. Ft.

Dry Hole _____

Abandoned _____

Date

OCT 28 1925

192

S. J. LEWIS

Scout