KANSAS

KANSAS Pawnee


FORM 51 10M 12-46 PETROL

Section 14 Township 20 Range 16W

Well No. 1 Dirks

Company W. H. Black

Pawnee Rock

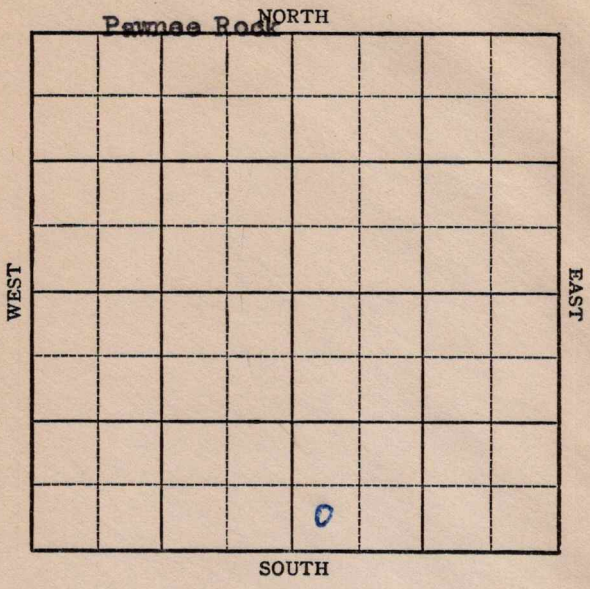

FORM 252-A
5M 9-47 PETROL

KANSAS

Pawnee

Sec. 14 Twp. 20 R. 16W

Well No. #1 Dirks Farm

W.H. Black Company

Pawnee Rock


Ft. from N. Line

330 Ft. from S. Line

Ft. from E. Line

330 Ft. from W. Line

SW SE

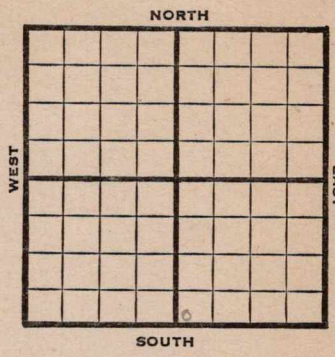

1947	Elev. 2040' REPORT
9/10	Drlg. 800
9/17	8" @ 1063' Drlg. 2990'
9/24	Lansing 3464' Simpson sd 3779-83' Arbuckle 3786' 3792' TD so 5" @ 3787' RUST
10/1	3797' sso &W.
10/8	TD 3798' Swb 146 bbls oil in 14 hrs.
10/15	"
10/22	Arbuckle 3786' 5" @ 3787' 500 Acid Pump 25 Pot Gr. 39° Total Depth 3797'

COMPLETED

Form 26 200 Bks. 10-46 Petrol

Kansas

Pawnee Rock

Map No. _____ Sec. 14 Twp. 20 R. 16W


Well No. 1 Dirks

W. H. Black Company

FIRST REPORT Contractor

SW SE

SECTION PLAT

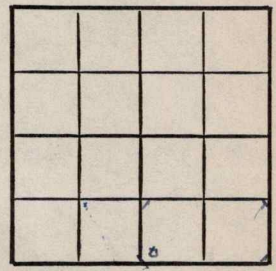

_____ Ft. from N. Line

330 Ft. from S. Line

_____ Ft. from E. Line

330 Ft. from W. Line

Pawnee County

Location _____

Rig up _____

Drilling and Remarks:

drlg. 800

RECORD

Cased _____ in., _____ ft.

Sand _____

Gas _____

Oil _____

Total Depth _____

PRODUCTION

1st 24 hrs. Nat. _____

1st 24 hrs. after shot _____

Gas _____ Cu. Ft.

Dry Hole _____

Abandoned _____

Date

SEP 10 1947 19 S. J. LEWIS Scout

Form 26 200 Bks. 10-46 Petrol

Kansas

Pawnee Rock Pool

Map No. 81 Sec. 14 Twp. 20 R. 16W

Well No. 1 Dirks


W. H. Black Company

COMPLETE Contractor

SW SE

E1.2040

SECTION PLAT

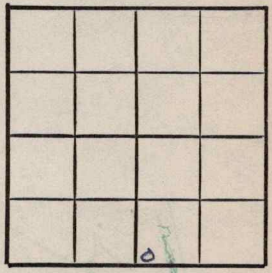

Ft. from N. Line

330 Ft. from S. Line

Ft. from E. Line

330 Ft. from W. Line

Pawnee County

Location

Rig up

Drilling and Remarks:

Cr X3786

5"@3787

500 acid

Pump 25 BX

8 5/8"

RECORD

Cased in., ft.

Sand

Gas

Oil

Total Depth 3787

PRODUCTION

1st 24 hrs. Nat.

1st 24 hrs. after shot

Gas Cu. Ft.

Dry Hole

Abandoned

Date

OCT 22 1947 19

S. J. LEWIS Scout