


Section 14 Township 25 Range 3EWell No. #1 FreemanCompany R. J. Wickson

NORTH

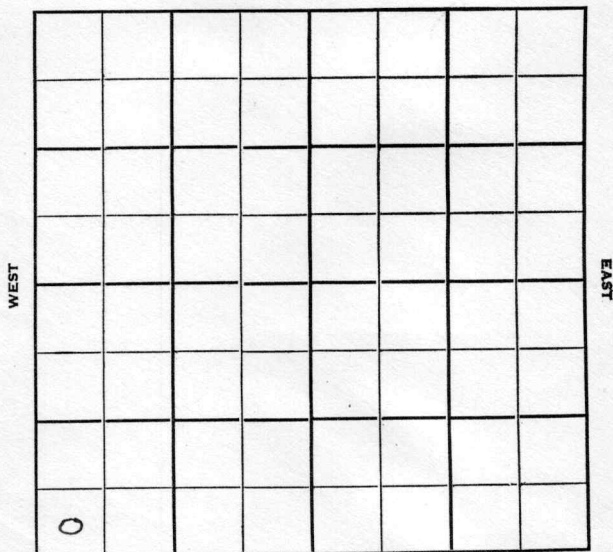

SOUTH

Sec. 14 Twp. 25 R. 3E

Well No. #1 Freeman Farm

R. J. Wickson Company

Contractor


Ft. from N. Line

330 Ft. from S. Line

Ft. from E. Line

330 Ft. from W. Line

SW SW SW

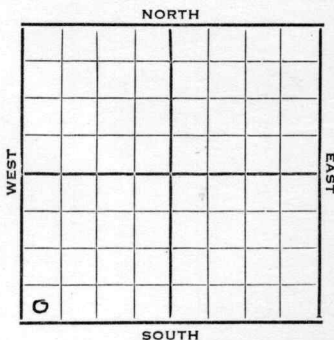

1952

Elev. 1330' REPORT

2/27

Pits

4/9

Spud 3-8-52

D&A TD 2806

13" @ 170 10" @ 1390

Lans. 1993 8" @ 2165


KC 2300 Cong. 2712

Miss 2719 TD 2806

D&A

ABANDONED

County **Butler** State **Kansas**
Sec. **14** (Blk. **25** (Sur. **3E** Map No.
Operator **R. J. Wickson**
Well No. **1** Farm **Freeman**
Elev. Location **SW SW SW**

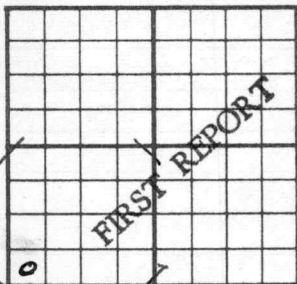

330 Ft. From **S** Line **SW**

330 Ft. From **W** Line Quarter

1st. Report **FEB 27 1952**

Completion

Remarks


Spudding Date

Drlg. Data

Pits

J. G. McGEHEE

County Butler State Kansas
 Sec. 14 (Blk. 25 (Sur. 3E (Rge. 3E Map No.)
 Operator R. J. Wixson
 Well No. 1 Farm Freeman
 Elev. 1330 Location SW SW SW

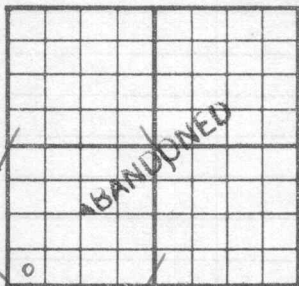

330 Ft. From S Line SW
330 Ft. From W Line Quarter

1st. Report

Completion APR 9 1952

Remarks

Spudding Date 3-8-52

Drilg. Data D & A TD 2806

13" @ 170 10" @ 1390 Lans. 1993

8" @ 2165 KC 2300 Cong. 2712

Miss. 2719 TD 2806

D & A

J. G. McGEHEE