


Section 22 Township 25 Range 3E

Well No. #1 Hopkins

Company R. J. Wickson

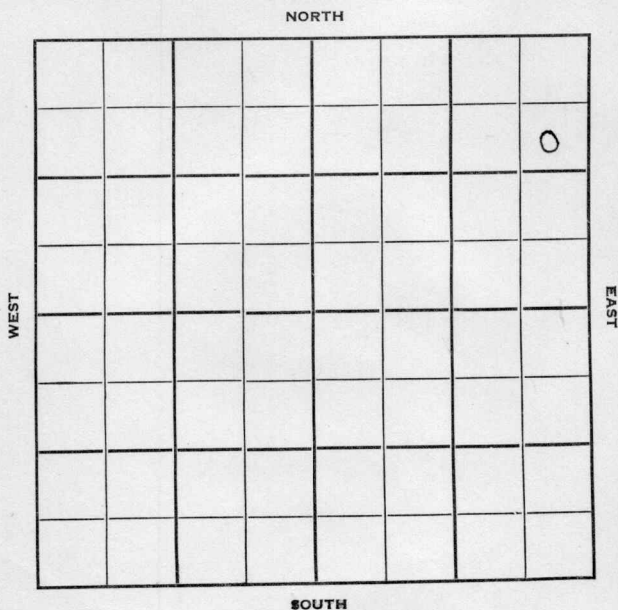

Butler KANSAS

Sec. 22 Twp. 25 R. 3 E

Well No. # 1 Hopkins Farm

R. J. Wickson Company

Wickson Contractor

Murdock


990 Ft. from N. Line

Ft. from S. Line

330 Ft. from E. Line

Ft. from W. Line

SE NE NE

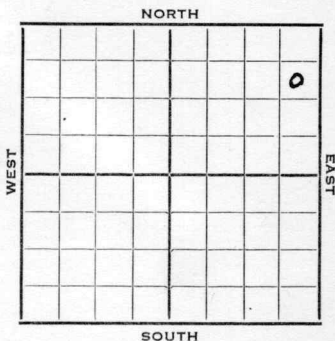

1952

Elev. 1336' REPORT

4/16

MICT

5/28

Spud 4-22-52

D&A TD 2757

12" @ 123 10" @ 1365 8" @ 2130

KC 2265 Miss 2740 7" @ 2740

TD 2757 1000 A D&A


ABANDONED

County **Butler** State **Kansas**
 Sec. **22** (Blk.) **25** (Sur.) **3E** Map No.

Operator **R. J. Wickson**

Well No. **1** Farm **Hopkins**

Elev. Location **SE NE NE**

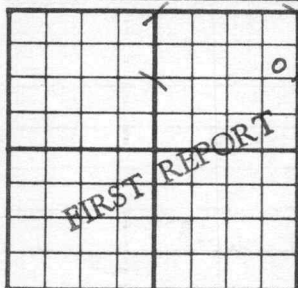

990 Ft. From **N** Line **NE**

330
990 Ft. From **E** Line Quarter

1st. Report **APR 16 1952**

Completion

Remarks

Wickson - Contr.

Spudding Date

Drlg. Data

Murdock

MIC


J. G. McGEHEE

County Butler State Kansas
 Sec. 22 (Blk.) 25 (Sur.) 3E Map No. (Twp.) (Rge.)

Operator R. J. Wixson

Well No. 1 Farm Hopkins

Elev. 1336 Location SE NE NE

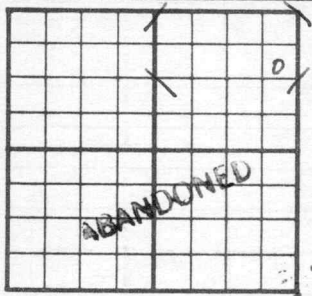

990 Ft. From N Line NE

330 Ft. From E Line Quarter

1st. Report

Completion MAY 28 1952

Remarks Murdock Pool

Wixson - Contr.

Spudding Date 4-22-52

Drlg. Data D & A TD 2757

12" @ 123 10" @ 1365 8" @ 2130

KC 2265 Miss. 2740 7" @ 2740

TD 2757 1000 A

D & A

J. G. McGEHEE