

Section 23 Township 25 Range 3E

Well No. #1 Brainerd

Company R. J. Wixson

NORTH

WEST

EAST

0							

SOUTH

Sec. 23 Twp. 25 R. 3 E

Well No. # 1 Brainerd Farm

R. J. Wixson Company

Contractor

Wildcat


330 Ft. from N. Line

Ft. from S. Line

Ft. from E. Line

330 Ft. from W. Line

NW NW NW

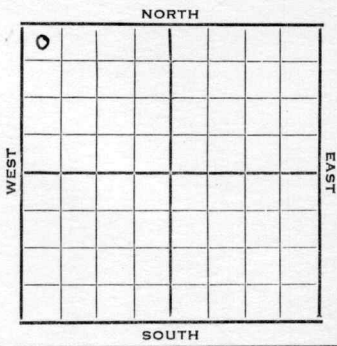

1951 Elev. 1317' REPORT

11/21 RUR

1952  
2/6 TD 2749 5" @ 2720

2/13 Spud 11-26-51  
Oil Well TD 2749  
15" @ 110 10" @ 1620  
8" @ 2125  
KC 2260 Cong. 2680  
Miss 2704 Lime 2710  
5" @ 2720 TD 2749  
2 bailers oil phr PB 2719  
B/2 go 20 gw 2000 A  
Comp. 8 bopd 5 bw

**COMPLETED**

County Butler State Kansas

Sec. 23 (Blk.) 25 (Sur.) 3E (Twp.) Map No.

Operator R. J. Wixson

Well No. 1 Farm Brainerd

Elev. Location NW NW NW

0				

330 Ft. From N Line NW

330 Ft. From W Line Quarter

1st. Report NOV 21 1951

Completion \_\_\_\_\_

Remarks \_\_\_\_\_

Spudding Date \_\_\_\_\_

Drlg. Data Wildcat

RUR

J. E. TYRA

County Butler State Kansas

Sec. 23 (<sup>Blk.</sup><sub>Twp.</sub>) 25 (<sup>Sur.</sup><sub>Rge.</sub>) 3 E Map No.

Operator R. J. Wixson

Well No. 1 Farm Brainerd

Elev. 1317 Location NW NW NW

o					

COMPLETE

330 Ft. From N Line NW

330 Ft. From W Line Quarter

Ist. Report

Completion FEB 13 1952

Remarks Wildcat

Spudding Date 11-26-51

Drlg. Data Oil well TD 2749

15" @ 110 10" @ 1620 8" @ 2125

KC 2260 Cong. 2680 Miss. 2704

Lime 2710 5" @ 2720 TD 2749

2 bailers oil ph PB 2719 B/ 2 go 20 gw

2000 A Comp. 8 bopd 5 bw