

Butler

KANSAS

SECTION 23 TOWNSHIP 25 RANGE 3 E

WELL NO. #3 Brainerd

COMPANY Wixson & A. D. Allison

NORTH

0							

WEST

EAST

SOUTH

Butler

KANSAS

SEC.

23

TWP.

25

R.

3E

WELL NO.

#3 Brainerd

FARM

COMPANY

Wixson & A. D. Allison

CONTRACTOR

Wixson


Murdock

Ft. from N. Line

Ft. from S. Line

Ft. from E. Line

Ft. from W. Line

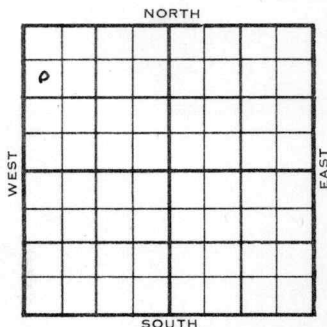

SW NW NW

1955

ELEVATION

1326'

REPORT

10/26

M I M

11-30

Comm. 11-2-55

13" @ 855

10" @ 1648

8 5/8" @ 2117

D& A

L. 1980

K.C. 2265

M. ### 2722

T.D. 2875.

ABANDONED

[illegible]

County Butler Elev. 1326 Co. 3E
 Sec. 23 Twp. 25 Rgs. 3E
 Company Wixson & A. D. Allison
 Farm Name Brainerd No. 3

TOPS	DEPTH	LOG	DATUM	Loc. in Sec.
Anh.				SW NW NW
Tp.				
H.				
Tr.				
Dg.				
Bl.				
L.	<u>1980</u>		<u>654</u>	Geol.
K.C.	<u>2265</u>		<u>939</u>	Contr.
B.K.C.				<u>Wixson</u>
Ce.				Pool
C.				<u>Murdock</u>
M.	<u>2722</u>		<u>1396</u>	
M.				
K.				
Mz.				
Mq.				
V.				
S.				
S.				
A.				
R.				
Pe.				
G.				
T.D.	<u>2875</u>			

ABANDONED

Date Comm. 11-2-55 NOV 3 0 1955
13" @ 855 10" @ 1648 8 5/8" @ 2117

D & A