


Map No. _____ Sec. 4 Twp. 25 R. 9
Well No. 4 Henley Farm _____
Rogers Etal Company _____
NORTH

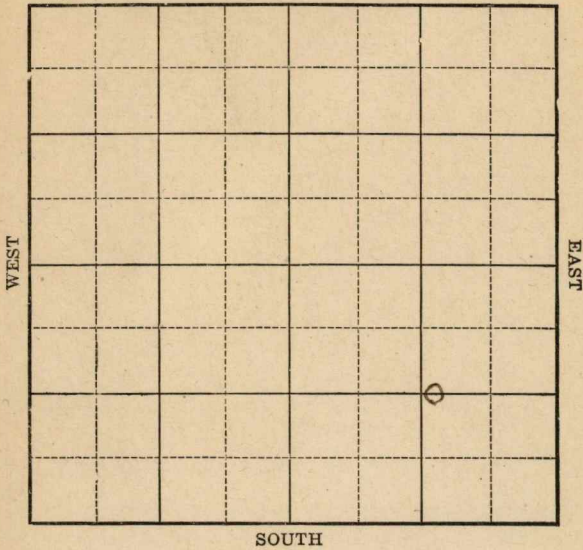

Location _____
Drilling Remarks: _____

Rig Up _____
Drilling Remarks: _____

RECORD

PRODUCTION

Cased _____ in. _____ ft.
Sand _____
Gas _____
Oil _____
Total Depth _____


1st 24 hrs. Nat. _____
1st 24 hrs. after shot _____
Gas _____ cu. ft.
Dry Hole _____
Abandoned _____

Map No. _____ Sec. 4 Twp. 25 R. 9Well No. 4 Henry Farm _____
Rogers et al Company _____

_____ Ft. from N. Line

1320 Ft. from S. Line1120 Ft. from E. Line

_____ Ft. from W. Line

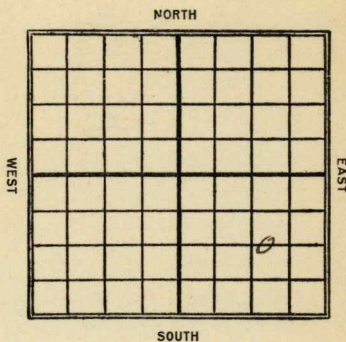Date
1923

REPORT

2/6 Rig
3/22 Trip and 2170 = Pay
 2182-2219 - Water bond
 2219-2223 - Shot 900 yds.
 90 Bbls.

Map No. KANSAS Sec. 4 Twp. 25 R. 9Well No. 4 HenryRogers et al Company

Contractor

FIRST REPORT

-----Ft. from N. Line

1320' Ft. from S. Line1120' Ft. from E. Line

-----Ft. from W. Line

SECTION PLAT

Location -----

Rig up -----

Drilling and Remarks:

RECORD

Cased ----- in., ----- ft.

Sand -----

Gas -----

Oil -----

Total Depth -----

PRODUCTION

1st 24 hrs. Nat. -----

1st 24 hrs. after shot -----

Gas ----- Cu. Ft.

Dry Hole -----

Abandoned -----

Date

FEB 6 1923

M. A. BENEAR

191

Scout

Map No. **KANSAS** ¹⁵ Sec. ⁴ Twp. ²⁵ R. ⁹

Well No. ⁴ *Henry*

Rogers, et al Company

Contractor

COMPLETED

SECTION PLAT

			③

_____ Ft. from N. Line

1320 Ft. from S. Line

1120 Ft. from E. Line

_____ Ft. from W. Line

Location _____

Rig up _____

Drilling and Remarks:

Tap S. 2170'
Pay 2182-2219
water sand 2219-2223
shot 90 gals
90 lbs.

RECORD

Cased _____ in., _____ ft.

Sand _____

Gas _____

Oil _____

Total Depth _____

PRODUCTION

1st 24 hrs. Nat. _____

1st 24 hrs. after shot _____

Gas _____ Cu. Ft.

Dry Hole _____

Abandoned _____

Date

MAR 22 1923

M. A. BENEAR

192

Scout