
FORM 51 Pawnee

KANSAS

Section 14 Township 20 Range 16W

Well No. 1 Nelson

Company Jayhawk Drlg.

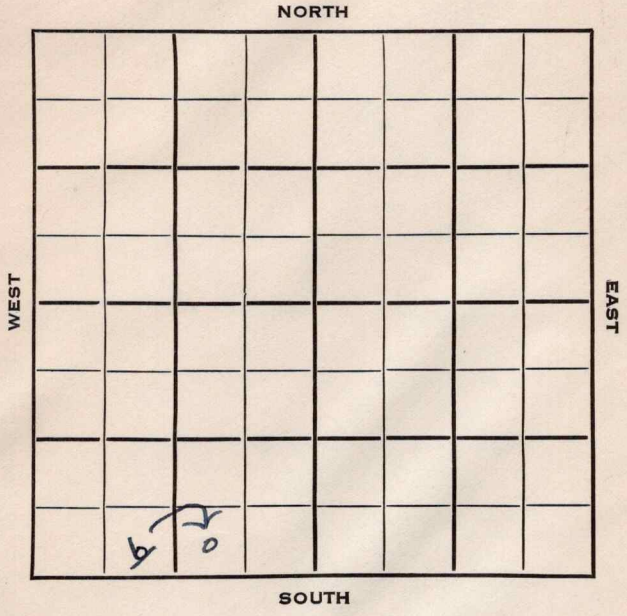

FORM 252-B

Pawnee

KANSAS

Sec. 14 Twp. 20 R. 16W

Well No. 1 Nelson Farm

Jayhawk Drlg. Company

Jayhawk Drlg. Contractor

Pawnee Rock Pool


Ft. from N. Line

330 Ft. from S. Line

990 Ft. from E. Line

~~990~~ Ft. from W. Line

~~SE SW SW~~
SW SE SW

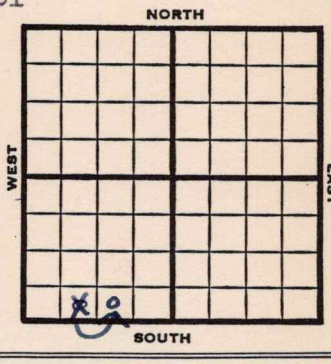

1952	REPORT
	Elev. 2046
12/30	MIR
1/1	MIR
1/8	Anhy 1061 8" @ 1069 Ø2200
1/22	Heeb 3381, Br Li 3458, Lans 3471, Arb. 3751 RTD 3799 5" @ 3799
1/29	CO TD wtr. PB
2/5	NR
2/11	Spudding Date 1/23 Oil well TD 3799½ Anhy 1061 8" @ 1069 Heeb. 3381 Br. Lime 3458 Lans. 3471 Arb. 3751 DST 3753-63 2 mcfg in 12 min. rec. 60' gcm 1070# DST 3773-88 4 1/3 mcfg 10 min. Rec. 140' gcm 1095# DST 3772-93 3 3/4 mcfg in 25 min. Rec. 135' gcm 1095# DST 3790-98 m mcfg 21 min. Rec. 5' gcm 120' oil 60' vhocm 1095# TD 3799½ 5" @ 3799 CO to 3799½ wtr. PB CO 3½ bsph PB 3792 10/3793-95 S & F/ 1 bop ph 1000A F/4 boph 16% wtr. Comp. 50 bopd 5% wtr.

COMPLETED

FORM 275 FOR SALE BY KANSAS BLUE PRINT CO.

County Pawnee State Kansas

Sec. 14 (Blk. Twp.) 20 (Sur. Rge.) 16W Map No.

Operator Jayhawk Drlg.

Well No. 1 Farm Nelson

Elev. Location SE SW SW



330 Ft. From S Line SW

990 Ft. From W Line Quarter

1st. Report DEC 30 1952

Completion

Remarks Jayhawk Drlg. - Contr.

Spudding Date

Drlg. Data Pawnee Rock Pool

M I R

J. G. McGEHEE

FORM 26 200 BKS. 4-52 PETROL

Kansas

Map No. _____ Sec. 14 Twp. 20 R. 16W

Well No. 1 Nelson


Jayhawk Drlg. Company

CORRECTION

_____ Contractor

SW SE SW

SECTION PLAT

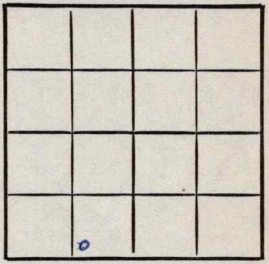

_____ Ft. from N. Line

330 Ft. from S. Line

990 Ft. from E. Line

_____ Ft. from W. Line

Pawnee County

Location _____

Rig up _____

Drilling and Remarks:

Reported
SE SW SW

RECORD

Cased _____ in., _____ ft.

Sand _____

Gas _____

Oil _____

Total Depth _____

PRODUCTION

1st 24 hrs. Nat. _____

1st 24 hrs. after shot _____

Gas _____ Cu. Ft.

Dry Hole _____

Abandoned _____

Date

JAN 14 1953 19 _____

J. G. McGEHEE Scout

FORM 275 FOR SALE BY KANSAS BLUE PRINT CO.

County Pawnee State Kansas

Sec. 14 (Blk. Twp.) 20 (Sur. Rge.) 16W Map No.

Operator Jayhawk Drlg.

Well No. 1 Farm Nelson

Elev. 2046 Location SW SE SW



330 Ft. From S Line SW

990 Ft. From E Line Quarter

1st. Report

Completion FEB 11 1953

Remarks Pawnee Rock Pool

Jayhawk Drlg. - Cntr.

Spudding Date 1-2-53

Drlg. Data Oil well TD 3799½

Anhy 1061 8" @ 1069 Heeb. 3381

Br. lime 3458 Lans. 3471 Arb. 3751

DST 3753-63 2 mcfg in 12 min. Rec. 60'

gcm 1070# DST 3773-88 4 1/3 mcfg 10min.

Rec. 140' gcm 1095# DST 3772-93

3 3/4 mcfg in 25 min. Rec. 135' gcm 1095#

DST 3790-98 m mcfg 21 min. Rec. 5' gcm

120' oil 60' vhocm 1095# TD 3799½

5" @ 3799 CO to 3799½ wtr. PB CO

3½ bwph PB 3792 10/ 3793-95 S & F/ 1 bop

ph 1000 A F/ 4 boph 16% wtr.

Comp. 50 bopd 5% wtr.

J. G. McGEHEE