


Rice

Form 51-5M-11-31-Palace

Map No. KANSAS Sec. 3 Twp. 21 R. 6^{2W}

Well No. 4 *Rainey* Farm
Rogers et al Company

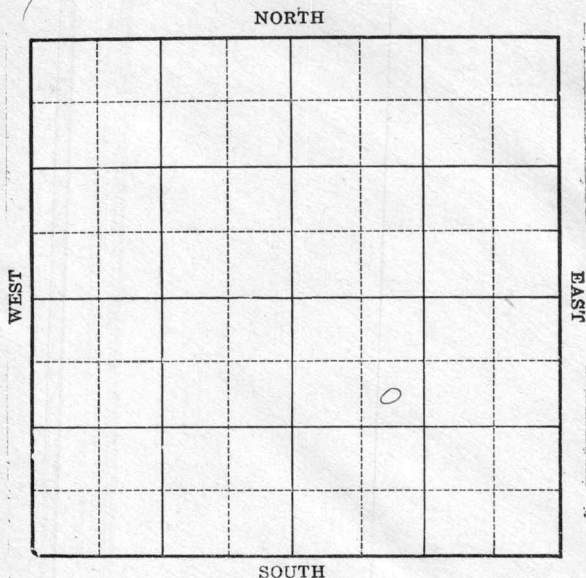

Location _____

Drilling Remarks _____

RECORD

Cased _____ in. _____ ft.

Sand _____

Gas _____

Oil _____

Total Depth _____

Rig Up _____

Drilling Remarks _____

PRODUCTION

1st 24 hrs. Nat. _____

1st 24 hrs. after shot _____

Gas _____ cu. ft.

Dry Hole _____

Abandoned _____

Map No. KANSAS Sec. 3 Twp 21 R. 6^W

Well No. 4 - Rainey Farm

Rogers et al Company


990 Ft. from N. Line

_____ Ft. from S. Line

_____ Ft. from E. Line

990 Ft. from W. Line

1933

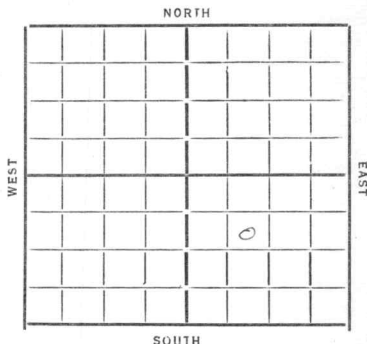

Date

REPORT

2/15	Loc
2/22	Orig
3/14	Rigging up
3/8	15" - 93' Hdg 170'
3/15	12" - 170' " 905
3/22	Dry 1750
3/29	10" 1912 Hdg 1960'
4/4	Tag 10" 2100
4/12	_____
4/19	_____
4/26	skiddling 25' south
5/4	15" 84' - 12" 170' spaced 230'
5/10	Dry 425'
5/17	" 1570'
5/24	" 1812
6/1	10" 1850 bly 2290
6/8	Truck 2505'
6/15	10" - 1910 Dry 2615'
6/21	U.P. 8" - 2800'
6/28	8" 2800' Dry 2875'
7/5	_____
7/12	a.D. 3104 for 26'

1933

7/19 6" 3107 drlg 3265

7/26 —

8/2 - Top chat 3267

T. D. 3297

37 bbls per hour

COMPLETED

48 KANSAS *Rice* W
 Map No. _____ Sec. *3* Twp. *21* R. *6*
 Well No. *4* *Rainey*
Rogers Gas _____ Company
 _____ Contractor

FIRST REPORTS

990 Ft. from N. Line
 _____ Ft. from S. Line
 _____ Ft. from E. Line
990 Ft. from W. Line

SECTION PLAT

Location *✓*

Rig up _____

Drilling and Remarks:

RECORD

Cased _____ in., _____ ft.

Sand _____

Gas _____

Oil _____

Total Depth _____

PRODUCTION

1st 24 hrs. Nat. _____

1st 24 hrs. after shot _____

Gas _____ Cu. Ft.

Dry Hole _____

Abandoned _____

Date

FEB 15 1933

192

CHAS. L. SHERWOOD

Scout

Map No. 48 Sec. 3 Twp. 21 R. 6W

Well No. 4 - Rainey

Rogers Company

Contractor


SECTION PLAT

990 Ft. from N. Line

..... Ft. from S. Line

..... Ft. from E. Line

990 Ft. from W. Line

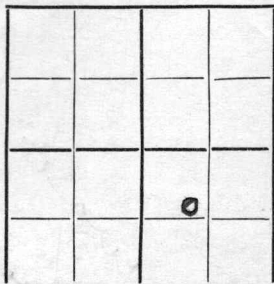

COMPLETED

Location.....

Rig up.....

Drilling and Remarks:

Top chat 3267

37 bbls per
hr

RECORD

Cased.....in.,ft.

Sand.....

Gas.....

Oil.....

Total Depth 3297

PRODUCTION

1st 24 hrs. Nat.....

1st 24 hrs. after shot.....

Gas.....Cu. Ft.

Dry Hole.....

Abandoned.....

Date

8/2/33 192 O. Mann Scout