


Map No. _____ Sec. 4 Twp. 25 R. 9
Well No. 6 Henley Farm _____
Rogers et al Company _____

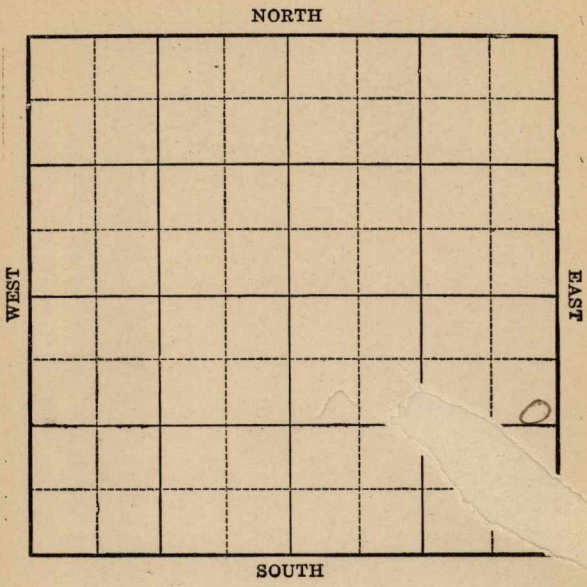

Location _____

Drilling Remarks:

Rig up _____

Drilling Remarks:

RECORD

Cased _____ in. _____ ft.

Sand _____

Gas _____

Oil _____

Total Depth _____

PRODUCTION

1st 24 hrs Nat. _____

1st 24 hrs. after shot _____

Gas _____ cu. ft.

Dry Hole _____

Abandoned _____

Map No. _____ Sec. 4 Twp. 25 R. 9

Well No. 6 Henley Farm _____
Rogers et al Company _____

NORTH

1120 Ft. from N. Line


_____ Ft. from S. Line

200 Ft. from E. Line

_____ Ft. from W. Line

WEST

EAST

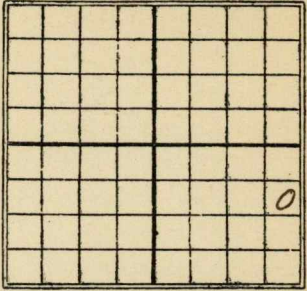

SOUTH

Date
1923

REPORT

3/2 Rig

5/7 Sand 2200-80-foot
160 gts. 150 Bbls.

Map No. **KANSAS** 15 Sec. **4** Twp. **25** R. **9**

Well No. **6** *Hensley*

Ragers et al Company

Contractor

FIRST REPORT

SECTION PLAT

1120 Ft. from N. Line

----- Ft. from S. Line

200 Ft. from E. Line

----- Ft. from W. Line

			○

Location -----

Rig up *✓✓* -----

Drilling and Remarks:

RECORD

Cased ----- in., ----- ft.

Sand -----

Gas -----

Oil -----

Total Depth -----

PRODUCTION

1st 24 hrs. Nat. -----

1st 24 hrs. after shot -----

Gas ----- Cu. Ft.

Dry Hole -----

Abandoned -----

Date
MAR 24 1923

M. A. BENEAR

Map No. **KANSAS**¹⁵ Sec. **4** Twp. **25** R. **9**

Well No. **6 Hunley**

Pagers et al Company

Contractor

COMPLETED SECTION PLAT

1120 Ft. from N. Line

_____ Ft. from S. Line

200 Ft. from E. Line

_____ Ft. from W. Line

			0

Location _____

Rig up _____

Drilling and Remarks:

*sand { 2200
12380
160/150 bbl.*

RECORD

Cased _____ in., _____ ft.

Sand _____

Gas _____

Oil _____

Total Depth _____

PRODUCTION

1st 24 hrs. Nat. _____

1st 24 hrs. after shot _____

Gas _____ Cu. Ft.

Dry Hole _____

Abandoned _____

Date

MAY 7 1923

M. A. BENEAR

191 _____

Scout