


Section 22 Township 25 Range 3E

Well No. #1 Frieman

Company E. H. Adair

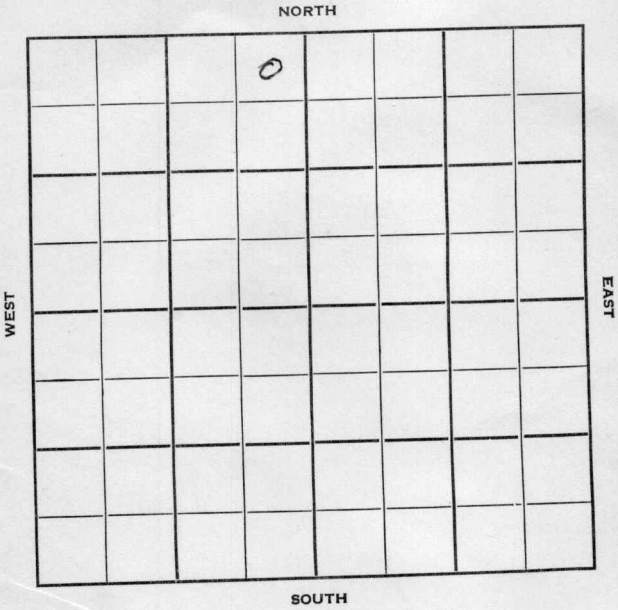

duplicate KANSAS

Butler

Sec. 22 Twp. 25 R. 3-E

Well No. #1 Frieman Farm

E H Adair Company

Contractor

Wildcat


330 Ft. from N. Line

Ft. from S. Line

330 Ft. from E. Line

Ft. from W. Line

NE NE NW

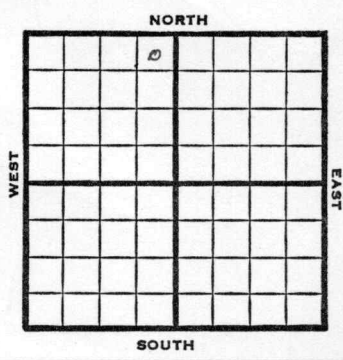

1950

Elev 1357' REPORT

1/18
3/8

RUR
TD 2795'
15" @ 162'
13" @ 1075'
10" @ 1965'
8" @ 2115'
7" @ 2730'
Miss 2779'
D&A
Aband.

ABANDONED

Kansas

Wildcat

Map No. _____ Sec. 22 Twp. 25 R. 3E

Well No. 1 Frieman

E. H. Adair _____ Company

Contractor

NE NE NW

SECTION PLAT

330 _____ Ft. from N. Line

_____ Ft. from S. Line

330 _____ Ft. from E. Line

_____ Ft. from W. Line

	0		

FIRST REPORT

Butler County

Location _____

Rig up _____

Drilling and Remarks:

R U R

RECORD

Cased _____ in., _____ ft.

Sand _____

Gas _____

Oil _____

Total Depth _____

PRODUCTION

1st 24 hrs. Nat. _____

1st 24 hrs. after shot _____

Gas _____ Cu. Ft.

Dry Hole _____

Abandoned _____

Date

JAN 18 1950 19

J. E. TYRA Scout

Map No. _____ Sec. 22 Twp. 25 R. 3E

Well No. 1 Frieman

E. H. Adair Company

Contractor

NE NE NW

El. 1357
SECTION PLAT

330 Ft. from N. Line

_____ Ft. from S. Line

330 Ft. from E. Line

_____ Ft. from W. Line

	0		
ABANDONED			

Butler County

Location _____

Rig up _____

Drilling and Remarks:

15" @ 162
13" @ 1075
10" @ 1965
8" @ 2115
7" @ 2730
Miss 2779

RECORD

Cased _____ in., _____ ft.

Sand _____

Gas _____

Oil _____

Total Depth 2795

PRODUCTION

1st 24 hrs. Nat. _____

1st 24 hrs. after shot _____

Gas _____ Cu. Ft.

Dry Hole _____

Abandoned _____

Date

D & A.

J. E. TYRA

MAR 8

1951

Scout