


Section 23 Township 25 Range 3 E

Well No. # 2 Brainerd

Company Wixson et al

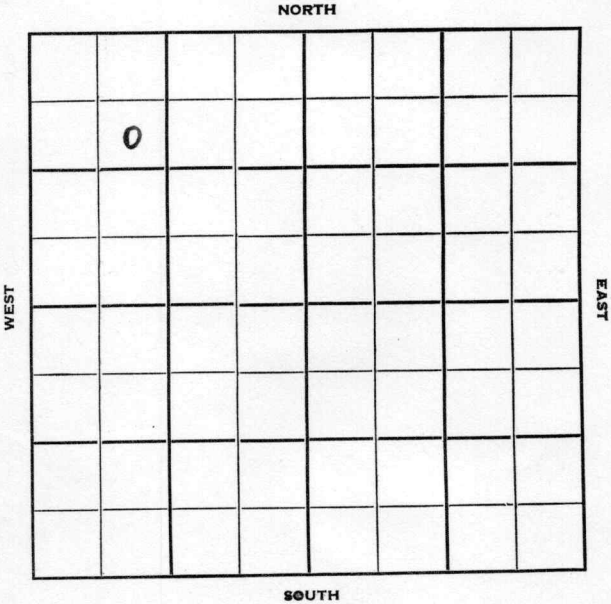

Butler

KANSAS

Sec. 23 Twp. 25 R. 3EWell No. #2 Brainerd FarmWixson et al CompanyWixson

Contractor


Murdock Pool990 Ft. from N. Line

Ft. from S. Line

Ft. from E. Line

990 Ft. from W. Line

SE NW NW

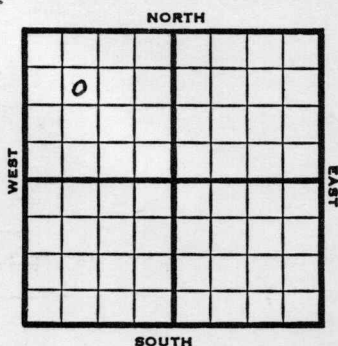

1953

Elev. 1311'

REPORT

6/17

R U

8/19

Spud 6-17-53

Oil Well

TD 2718

15" @ 118

10" @ 1375

8" @ 2125

Lans 1970, KC 2250', Miss 2703,

TD 2718

5" @ 2710

CO to 2718

FU 400' oil

Hydr.

S/l bo 1 bwph

CO to 2718

Comp. 15 bopd 1 bw

COMPLETED

Operator Wixson et al.

Well No. **2** Farm **Brainerd**

Elev.	Location	SE	NW	NW
-------	----------	----	----	----

[illegible]

990 Ft. From N Line NW

990 Ft. From W Line Quarter

1st. Report JUN 17 1953

Completion

Remarks


Wixson - Contr.

Spudding Date _____

Drlg. Data Murdock Pool

RU

County Butler State Kansas
 Sec. 23 (Blk. 25 (Sur. 3E Map No. 25 (Twp. Rge.)
 Operator Wixson etal.
 Well No. 2 Farm Brainerd
 Elev. 1311 Location SE NW NW

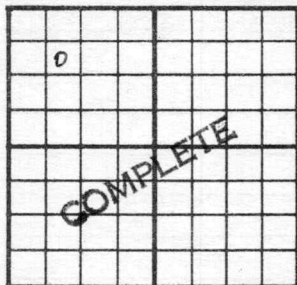

990 Ft. From N Line NW
 990 Ft. From W Line Quarter

1st. Report

Completion AUG 19 1953

Remarks Murdock Pool

Wixson - Contr.

Spudding Date 6-17-53

Drlg. Data Oil well TD 2718

15" @ 118 10" @ 1375 8" @ 2125

Lans. 1970 KC 2250 Miss. 2703

TD 2718 5" @ 2710 CO to 2718

FU 400' oil Hydr. S/ 1 bo 1 bwpd

CO to 2718 Comp. 15 bopd 1 bw

J. G. McGEHEE